




R = Iron Pipe Found
C = Iron Pipe Cap

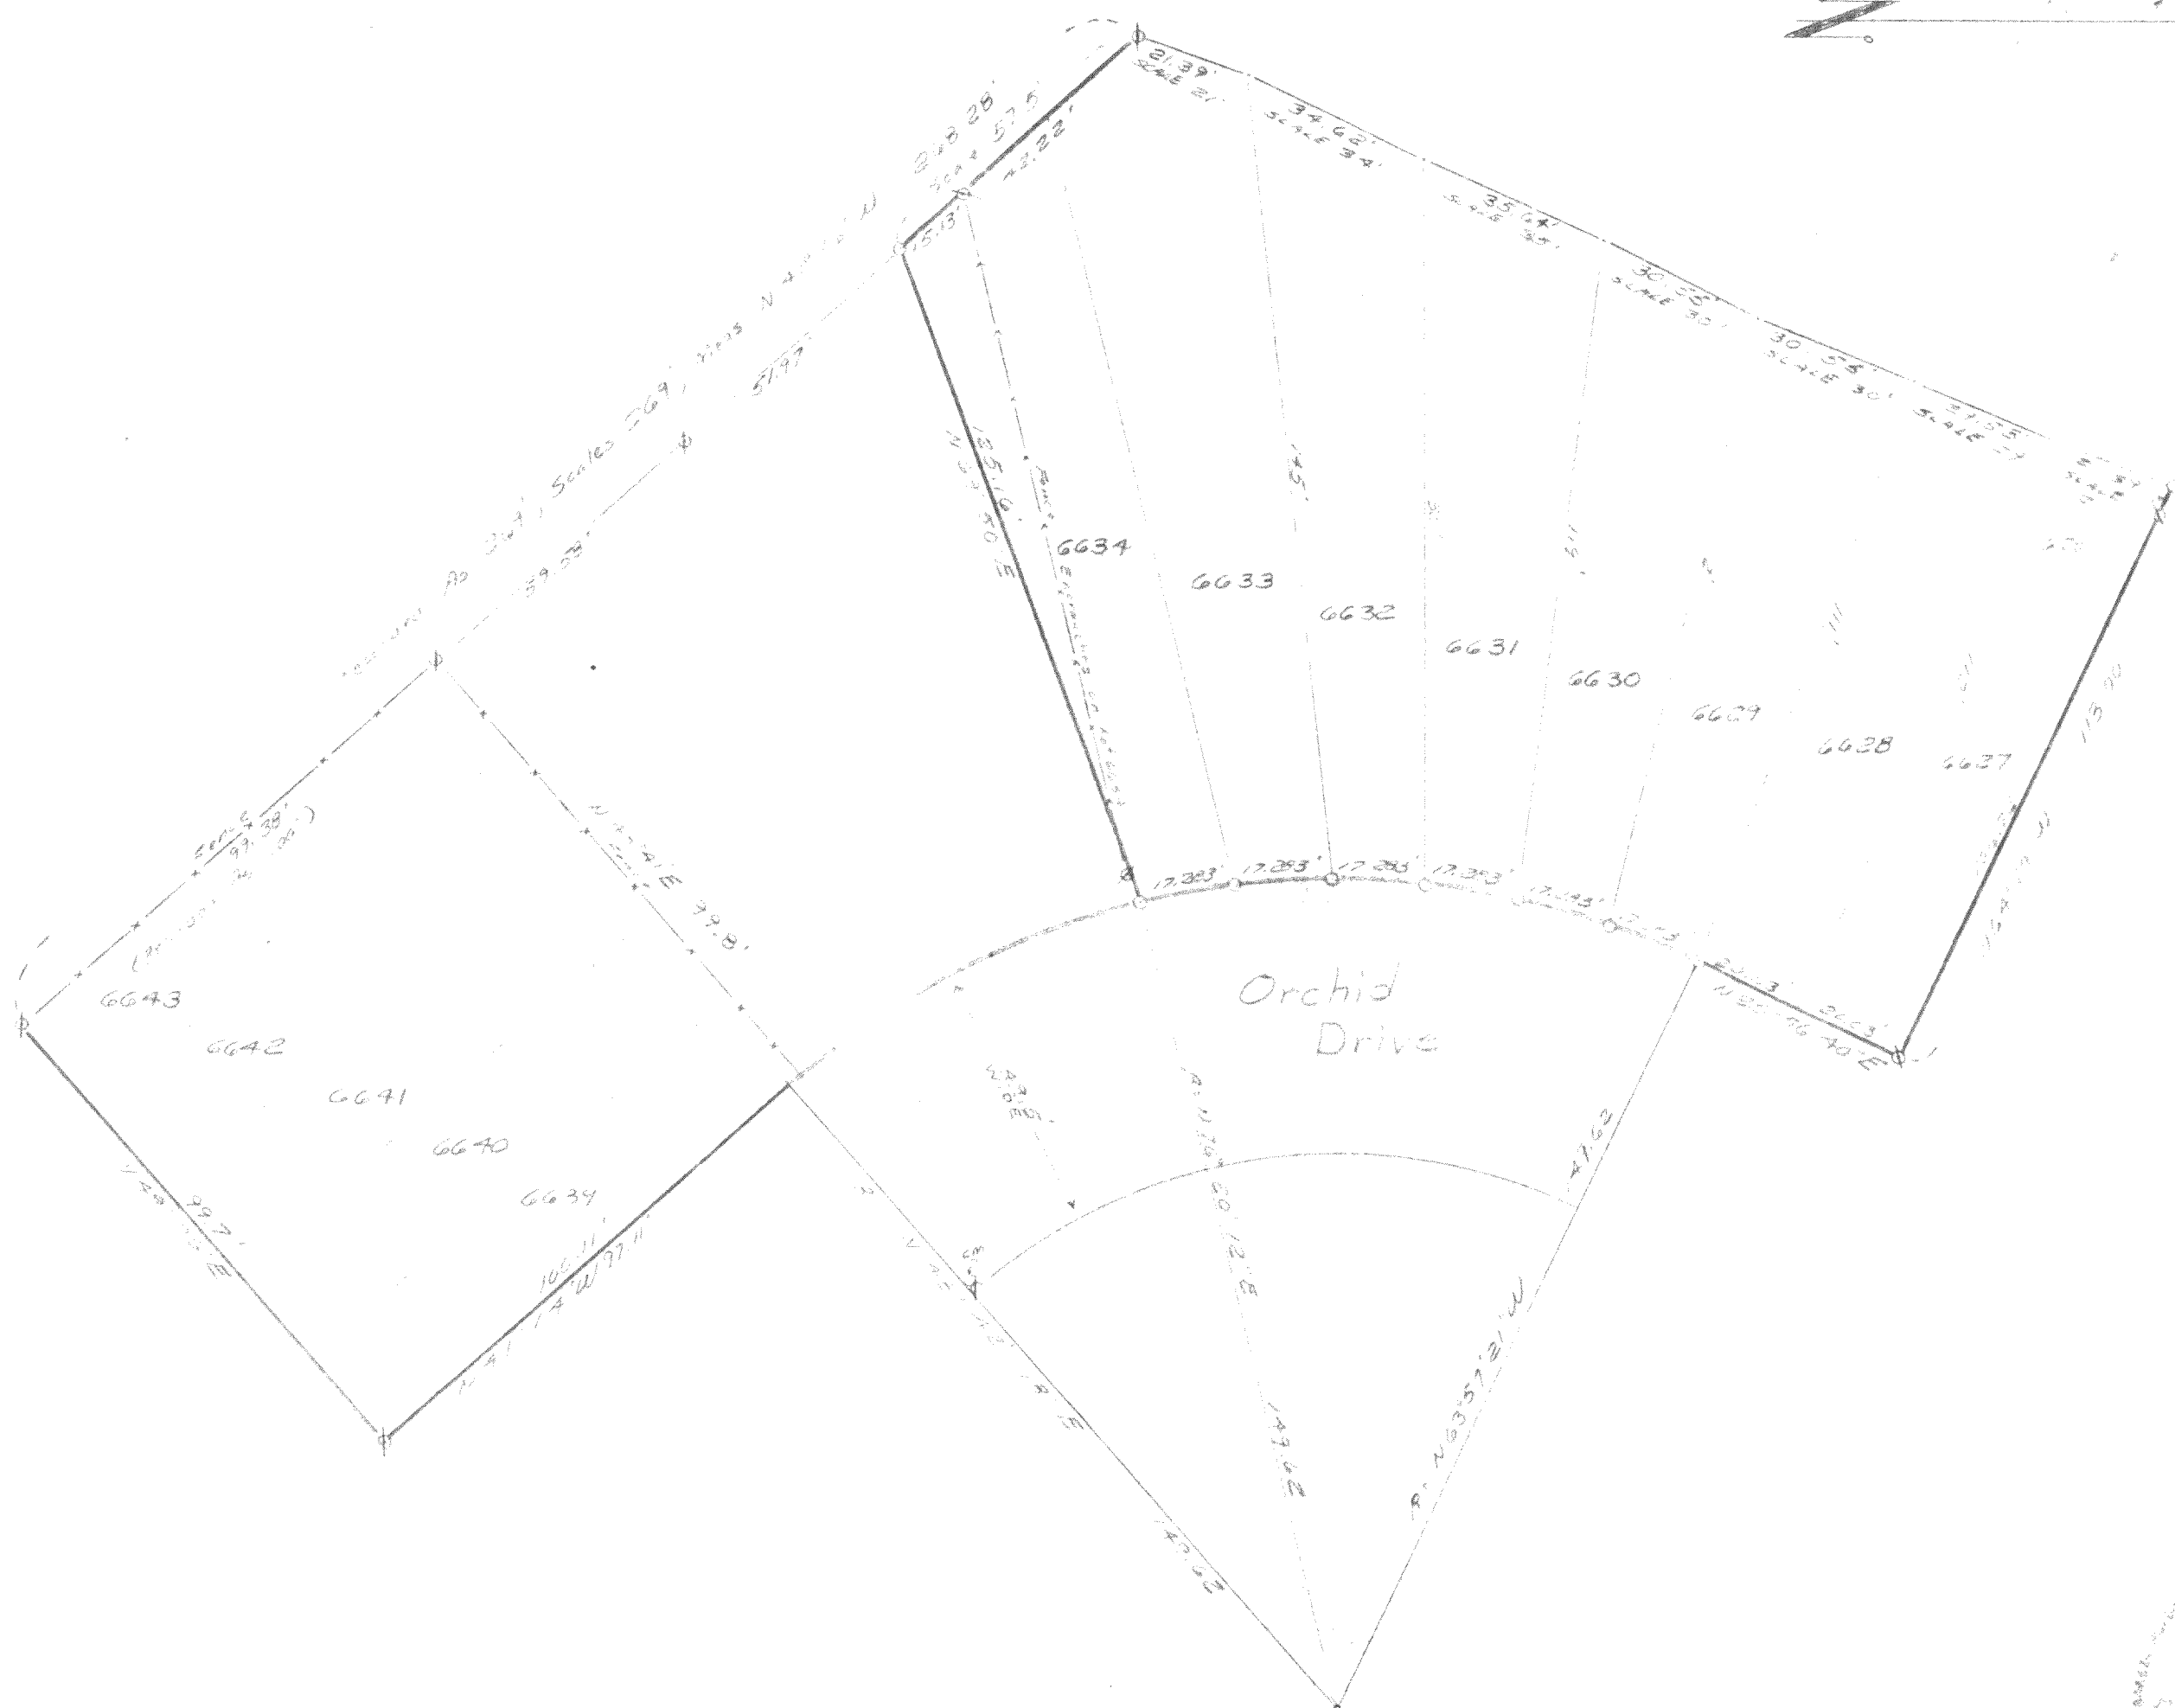

MPL 1047
1450

PLAT OF SURVEY OF

Lots 6627, 6628, 6629, 6630, 6631, 6632,
6633, 6634, 6635, 6636, 6637, 6638, 6639, 6640, 6641, 6642, 6643
Located in the Northwest 1/4 of Section 15,
Township 1 North, Range 8 East, Marathon County
Wisconsin. Lots are patrolled on Map of Section 4
Pelt Lake.

Roy L. Jensen
SURVEYOR

SCALE 1" = 30'

DATE 27 June 1973

WITNESSED 1 JUL 1973