


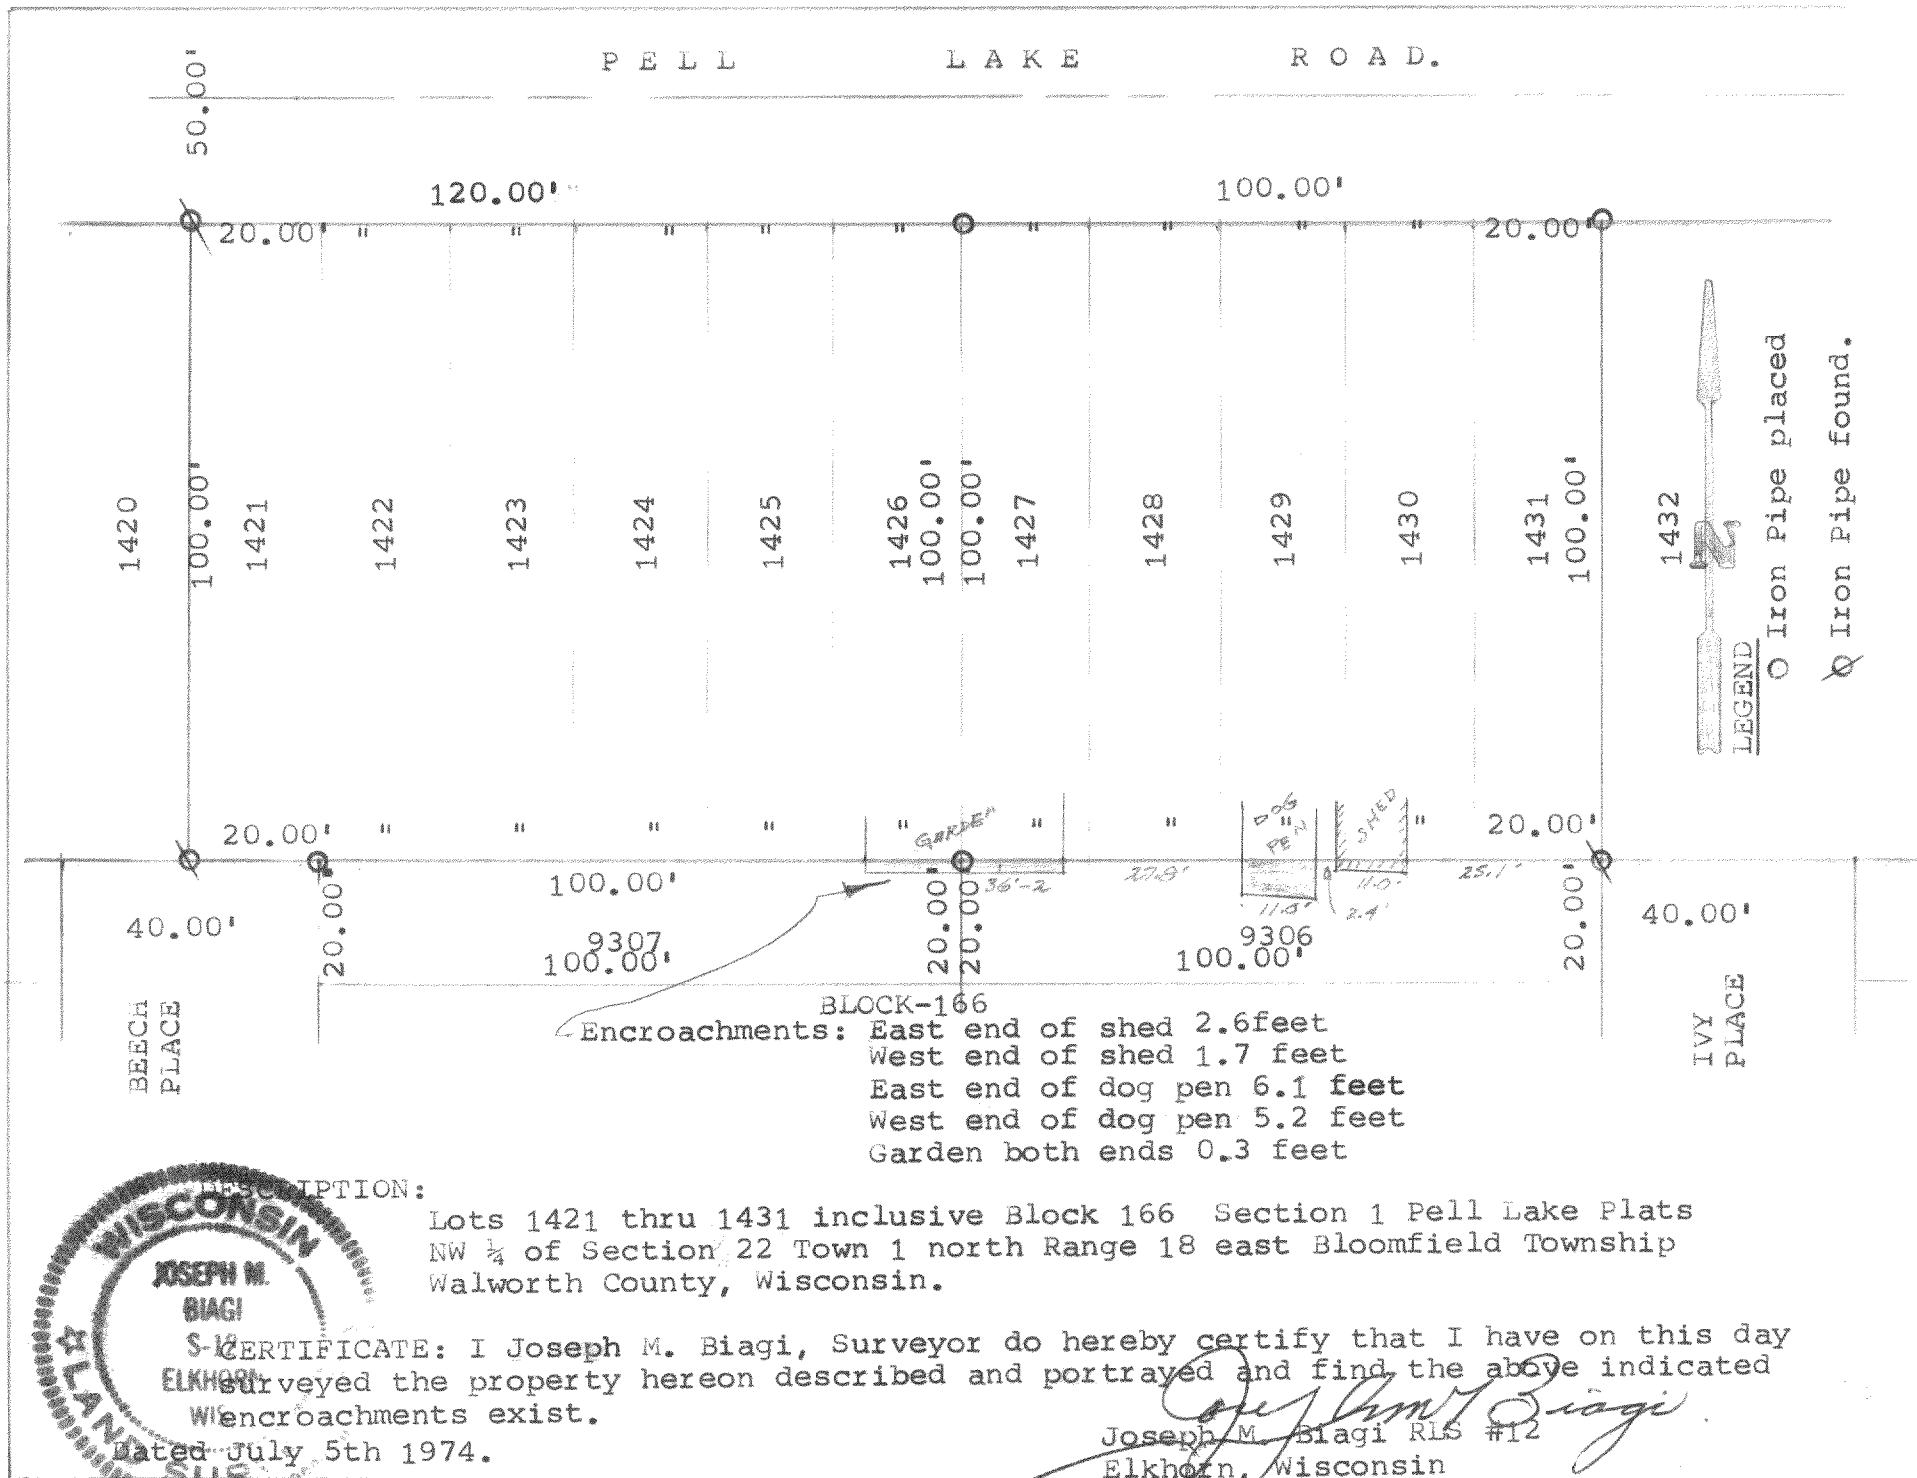

72-147

118-42B