


HAROLD H. KOLB
REGISTERED PROFESSIONAL LAND SURVEYOR
LAKE GENEVA, WISCONSIN

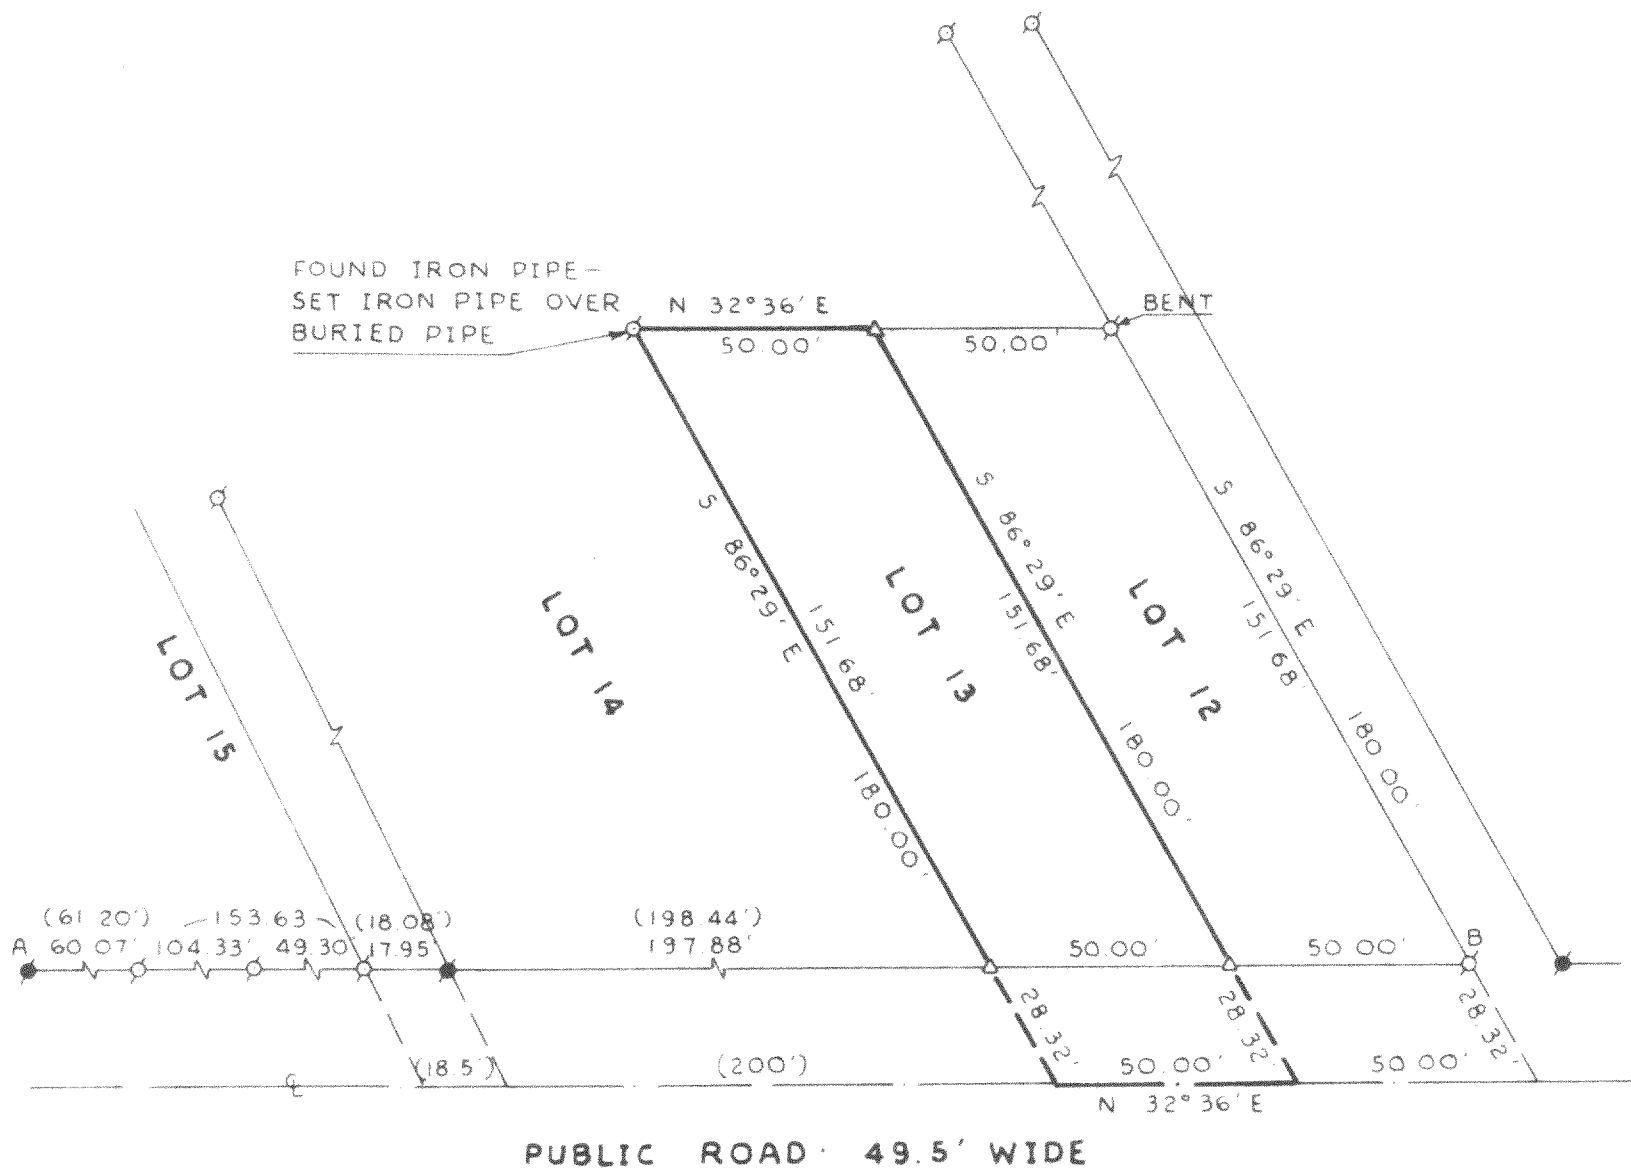

PLAT OF SURVEY OF

Lot 13, Zippel Subdivision, Section 13, T. 2 N.,
R. 18 E., Walworth County, Wisconsin.


NOTE: The centerline of the indicated "Public Road" is assumed N 32°36' E as plotted.

Plotted distance from A to B = 529.74' as computed
Field distance from A to B = 529.53' as measured



LEGEND

⊗ - IRON PIPE FOUND
○ - IRON PIPE PLACED
● - CONCRETE MONUMENT
x - SPIKE
△ - Set Iron Rod
() - Plotted Area

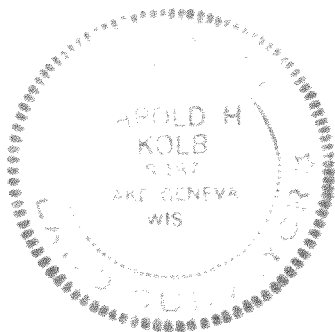

I, HAROLD H. KOLB, DO HEREBY CERTIFY THAT I HAVE SURVEYED THE PROPERTY HEREON DESCRIBED ACCORDING TO THE OFFICIAL RECORDS, AND THAT THE PLAT HEREON IS A CORRECT REPRESENTATION OF THE LOT LINES.

HAROLD H. KOLB
WISCONSIN REGISTERED LAND SURVEYOR, S-187
DATE June 8, 1979