

HAROLD H. KOLB

REGISTERED PROFESSIONAL LAND SURVEYOR
LAKE GENEVA, WISCONSIN


JUNEAU ROAD

40' WIDE

BLOCK 78

JASMINE DRIVE

40' WIDE

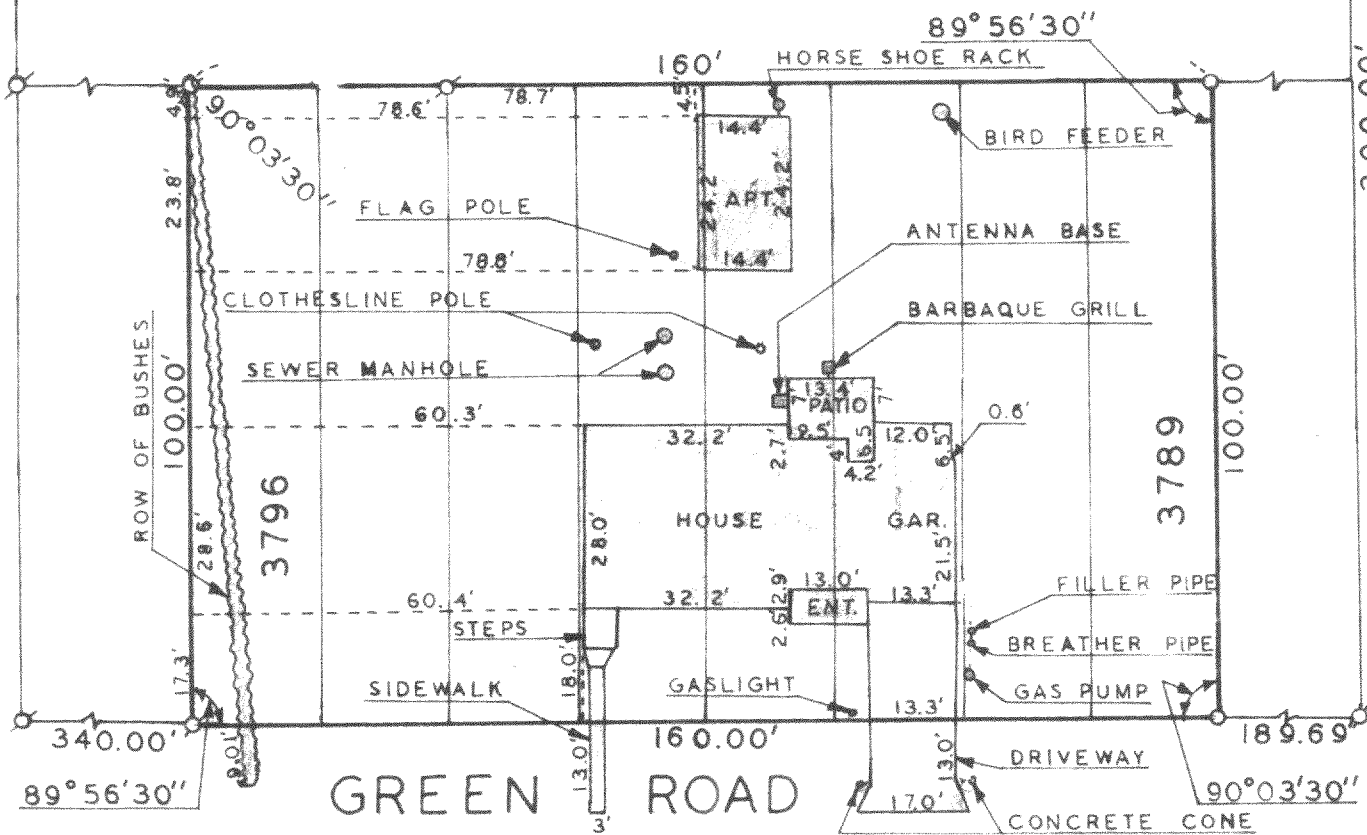

DAISY DRIVE

50' WIDE

GREEN ROAD

40' WIDE

Accuracy: Distances - $\pm 0.01'$
Angles - $\pm 0.01''$
Error of Closure - Less than
1/3000

PLAT OF SURVEY

Lots 3789-3796 in Block 78, T1N, R1E, S1W, 1/4 Sec. 15, T1N, R1E, S1W, Walworth County, Wisconsin.

Map No.

Ordered by: Walter Fitch of Hallmark Realty


N



SCALE: 1" = 30'

LEGEND

- — IRON PIPE FOUND
- — IRON PIPE PLACED
- — CONCRETE MONUMENT
- x — SPIKE

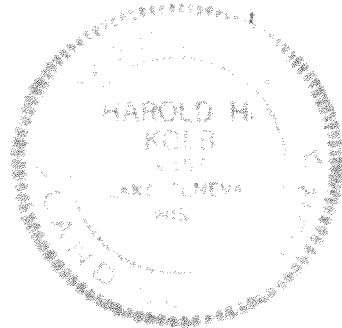

I, HAROLD H. KOLB, DO HEREBY CERTIFY THAT I HAVE SURVEYED THE PROPERTY HEREON DESCRIBED ACCORDING TO THE OFFICIAL RECORDS, AND THAT THE PLAT HEREON IS A CORRECT REPRESENTATION OF THE LOT LINES.

Harold H. Kolb
HAROLD H. KOLB

WISCONSIN REGISTERED LAND SURVEYOR, S-187
DATE Aug 2, 1974

118-448