


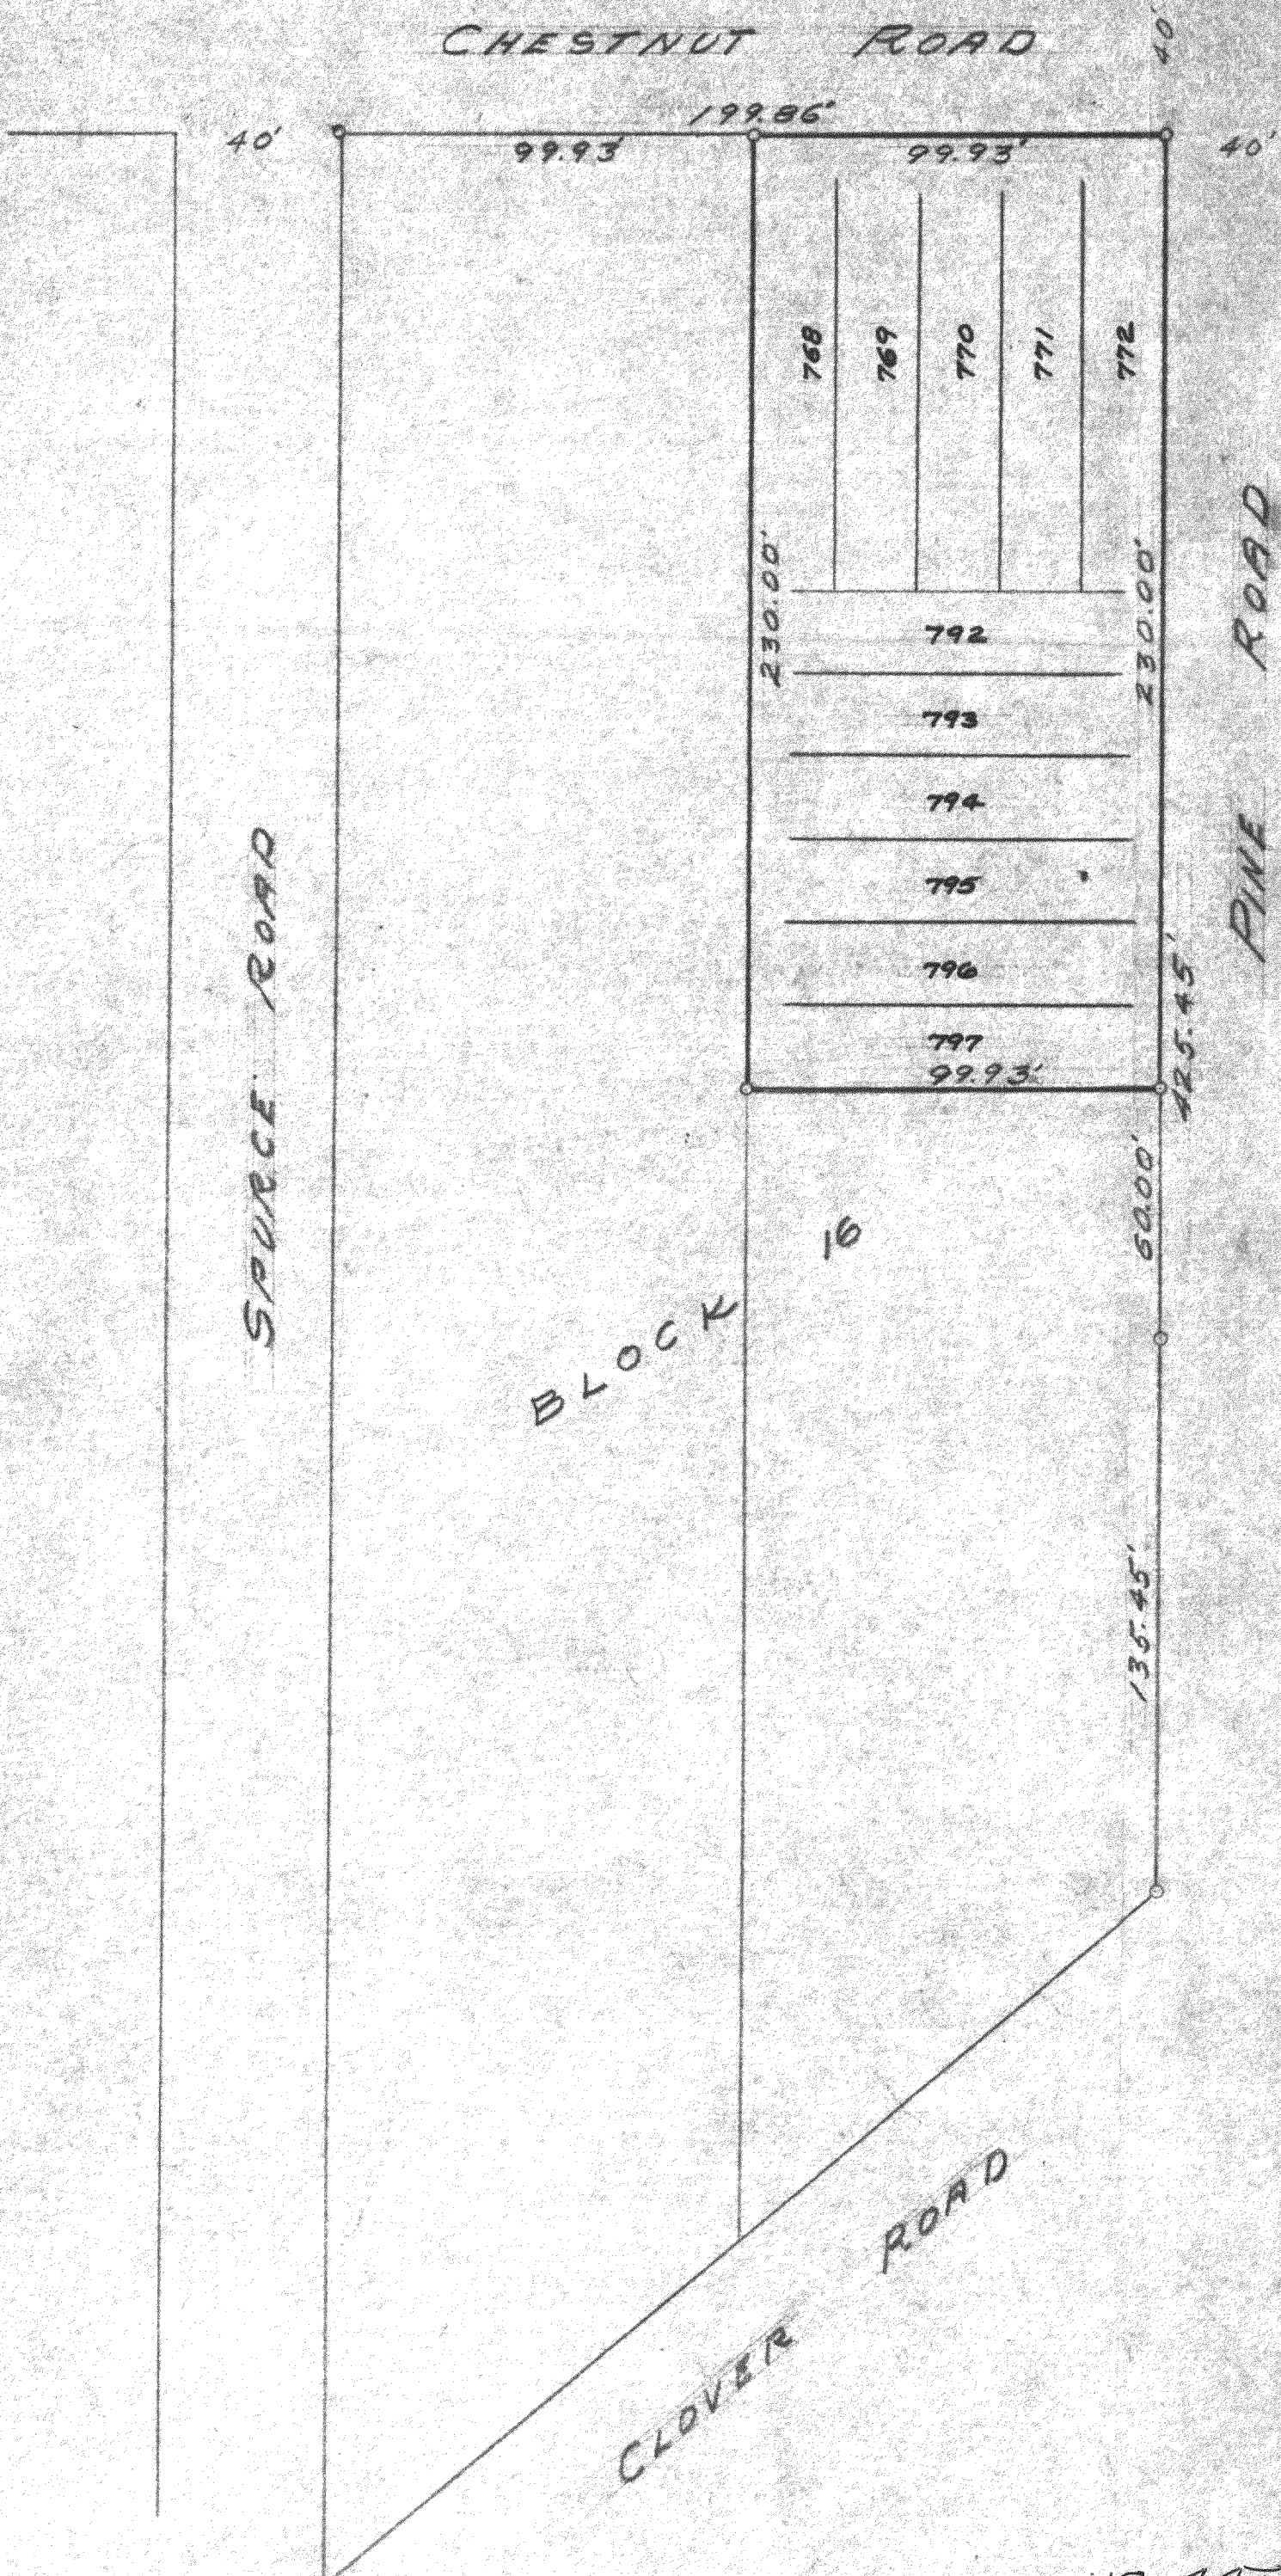

o = IRON PIPE

PLAT OF SURVEY
OF
LOTS 768-772 INCL.
AND
LOTS 792-797 INCL.
BLOCK 16 PELL LAKE SUBDIVISION
WALWORTH CO., WISCONSIN
Floyd L. Jensen
SURVEYOR
SCALE 1" = 40'
DATE JULY 1953

118-445