

HAROLD H. KOLB


REGISTERED PROFESSIONAL LAND SURVEYOR
LAKE GENEVA, WISCONSIN

PLAT OF SURVEY OF

Lot 7 and the North 39.00' of
Lot 8, Block 5, Rose Nippersink
Gardens Subdivision, T1N, R18E,
Walworth County, Wisconsin.

OWNER: Kenneth Deutsch

ACCURACY: Distances: $\pm 0.01'$
Angles: $\pm 05''$
Error of closure less
than 1/3000

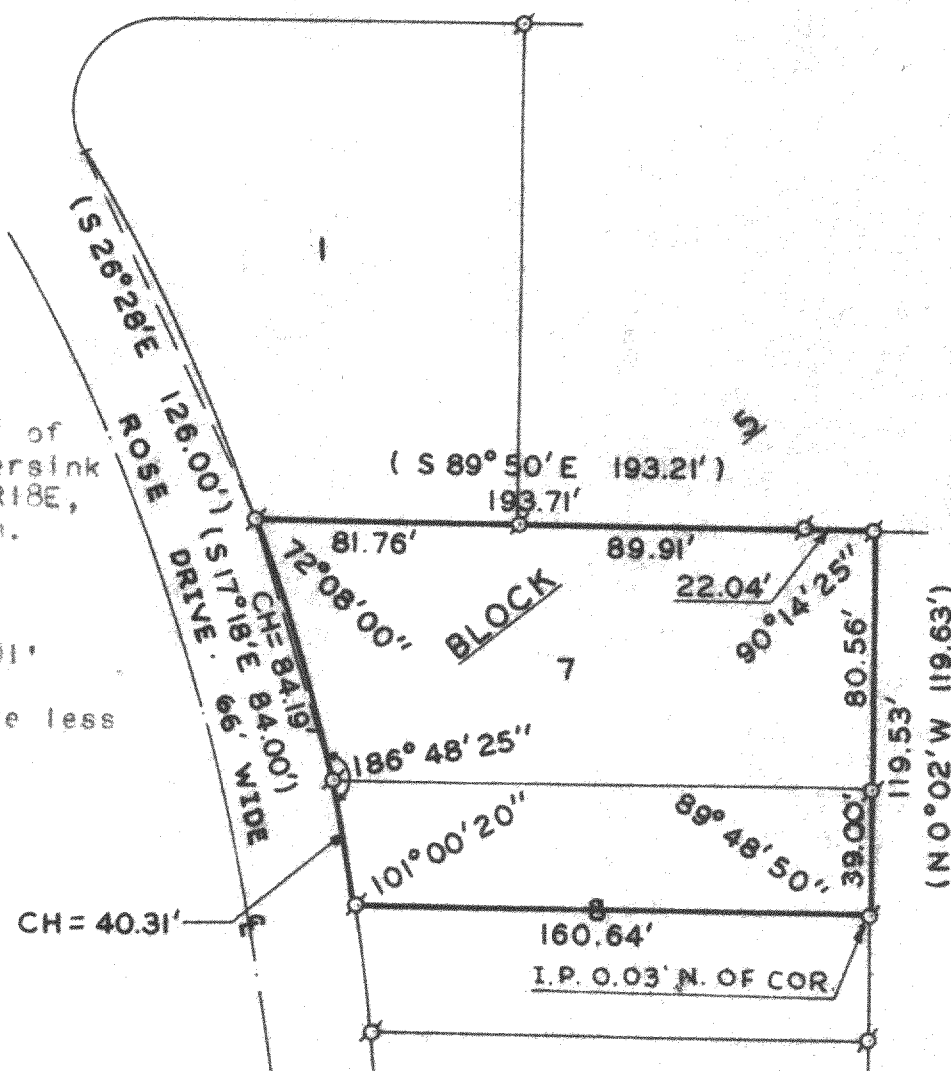


N



SCALE: 1"=60'

LEGEND

- φ - IRON PIPE FOUND
- - IRON PIPE PLACED
- - CONCRETE MONUMENT
- x - SPIKE
- () - Platted As

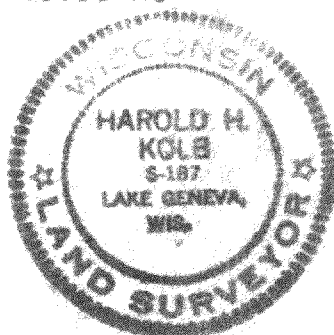

I, HAROLD H. KOLB, DO HEREBY CERTIFY THAT I HAVE
SURVEYED THE PROPERTY HEREON DESCRIBED ACCORDING
TO THE OFFICIAL RECORDS, AND THAT THE PLAT HEREON
IS A CORRECT REPRESENTATION OF THE LOT LINES.

Harold H. Kolb

HAROLD H. KOLB
WISCONSIN REGISTERED LAND SURVEYOR, S-187

DATE Aug 30, 1974

MRNG-42

118-462