

**REGISTERED PROFESSIONAL LAND SURVEYOR  
LAKE GENEVA, WISCONSIN**



Lot 13, Zuhde Subdivision, Section 13, T1N, R18E, Walworth County, Wisconsin, also a easement to Powers Lake.

NOTE: The centerline of the indicated "Public Road" is assumed N 32°36' E as platted.

Platted distance from A to B = 529.74' as computed  
Field distance from A to B = 529.53' as measured.

Right of Way in common with others

Approximate  
Original shore line


This area has been filled

Present shore line

LAKE



- X - IRON PIPE FOUND  
 O - IRON PIPE PLACED  
 \* - CONCRETE MONUMENT  
 I - SPIKE  
 Δ - Set Iron Rod  
 () - Platted As

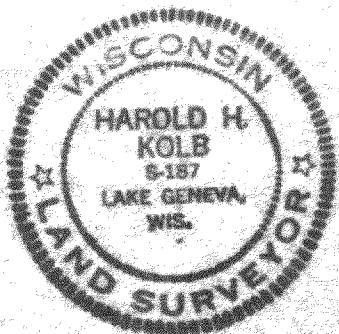

I, HAROLD H. KOLB, DO HEREBY CERTIFY THAT I HAVE SURVEYED THE PROPERTY HEREON DESCRIBED ACCORDING TO THE OFFICIAL RECORDS, AND THAT THE PLAT HEREON IS A CORRECT REPRESENTATION OF THE LOT LINES.

Harold H. Kolb  
 HAROLD H. KOLB  
 WISCONSIN REGISTERED LAND SURVEYOR, S-187  
 DATE Sept. 19, 1974

118-472