

HAROLD H. KOLB

REGISTERED PROFESSIONAL LAND SURVEYOR
LAKE GENEVA, WISCONSIN


PLAT OF SURVEY OF

Lots 2692-2704, Block 68, Section 2, T11N,
R18N, W18W, Walworth
County, Wisconsin.

ACCURACY: Distances 0.01'
Angles 05"

Error of Closure Less than 1/3000

OWNER: Thelma Pearson
Lake Shore Drive
Pell Lake, W1. 53157

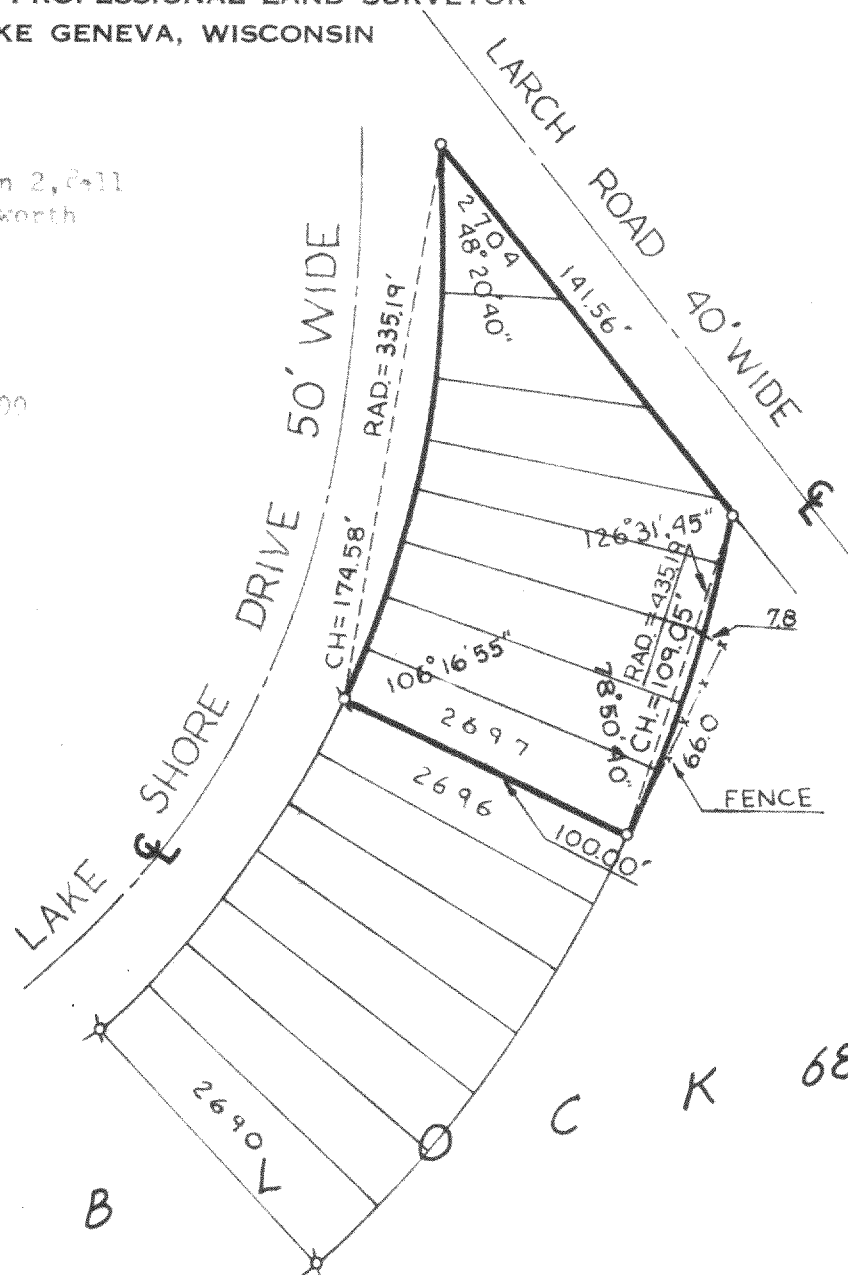


N



SCALE 1"=60'

LEGEND

- φ — IRON PIPE FOUND
- — IRON PIPE PLACED
- — CONCRETE MONUMENT
- x — SPIKE

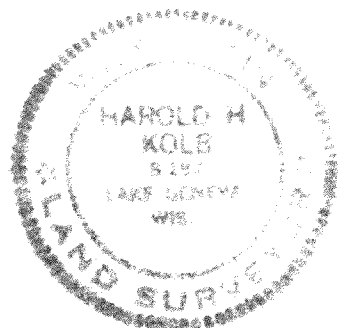

I, HAROLD H. KOLB, DO HEREBY CERTIFY THAT I HAVE
SURVEYED THE PROPERTY HEREON DESCRIBED ACCORDING
TO THE OFFICIAL RECORDS, AND THAT THE PLAT HEREON
IS A CORRECT REPRESENTATION OF THE LOT LINES.

Harold H. Kolb

HAROLD H. KOLB
WISCONSIN REGISTERED LAND SURVEYOR, S-187
DATE Feb. 25, 1915

118-475