


Parkway

Tombeau

Blvd. 70' Wide

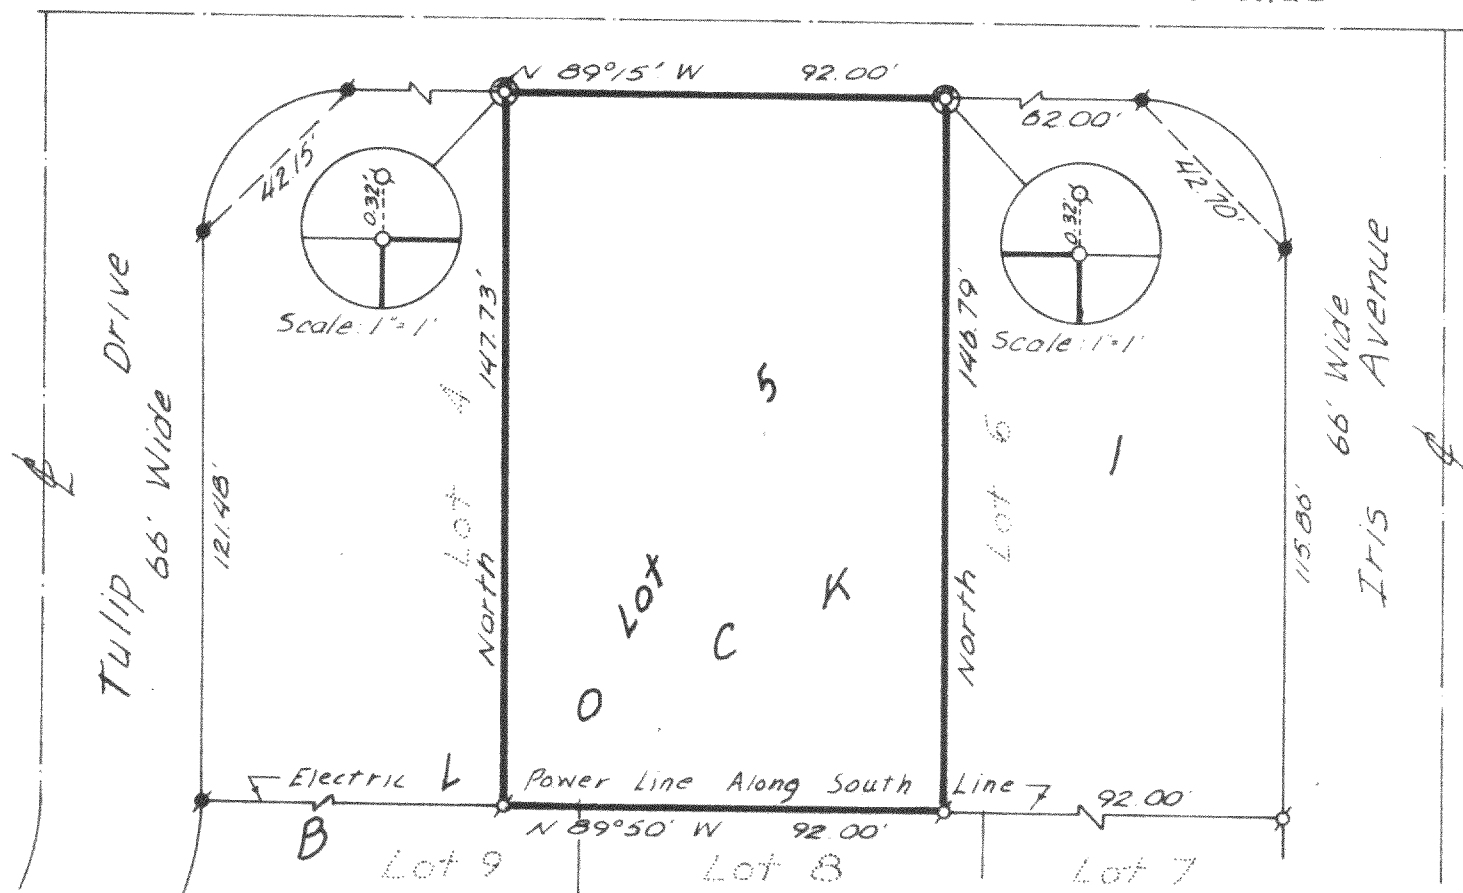

PLAT OF SURVEY OF

Lot 5, Block 1, Rose Nippersink Gardens Subdivision
T 1 N, R 18 E, Walworth County, Wisconsin.

ACCURACY: Distances $\pm .01'$
Angles $\pm 05''$
Error of closure less
than 1/3000

OWNER: George Horvath



Scale 1" = 40'

LEGEND

- φ --- IRON PIPE FOUND
 ○ --- IRON PIPE PLACED
 ● --- CONCRETE MONUMENT
 X --- SPIKE

I hereby certify that there are no buildings and no visible encroachments.

I, HAROLD H. KOLB, DO HEREBY CERTIFY THAT I HAVE SURVEYED THE PROPERTY HEREON DESCRIBED ACCORDING TO THE OFFICIAL RECORDS, AND THAT THE PLAT HEREON IS A CORRECT REPRESENTATION OF THE LOT LINES.

Harold H. Holt

HAROLD H. KOLB
WISCONSIN REGISTERED LAND SURVEYOR, S-187

DATE April 8, 1975

