


HAROLD H. KOLB

REGISTERED PROFESSIONAL LAND SURVEYOR
LAKE GENEVA, WISCONSIN

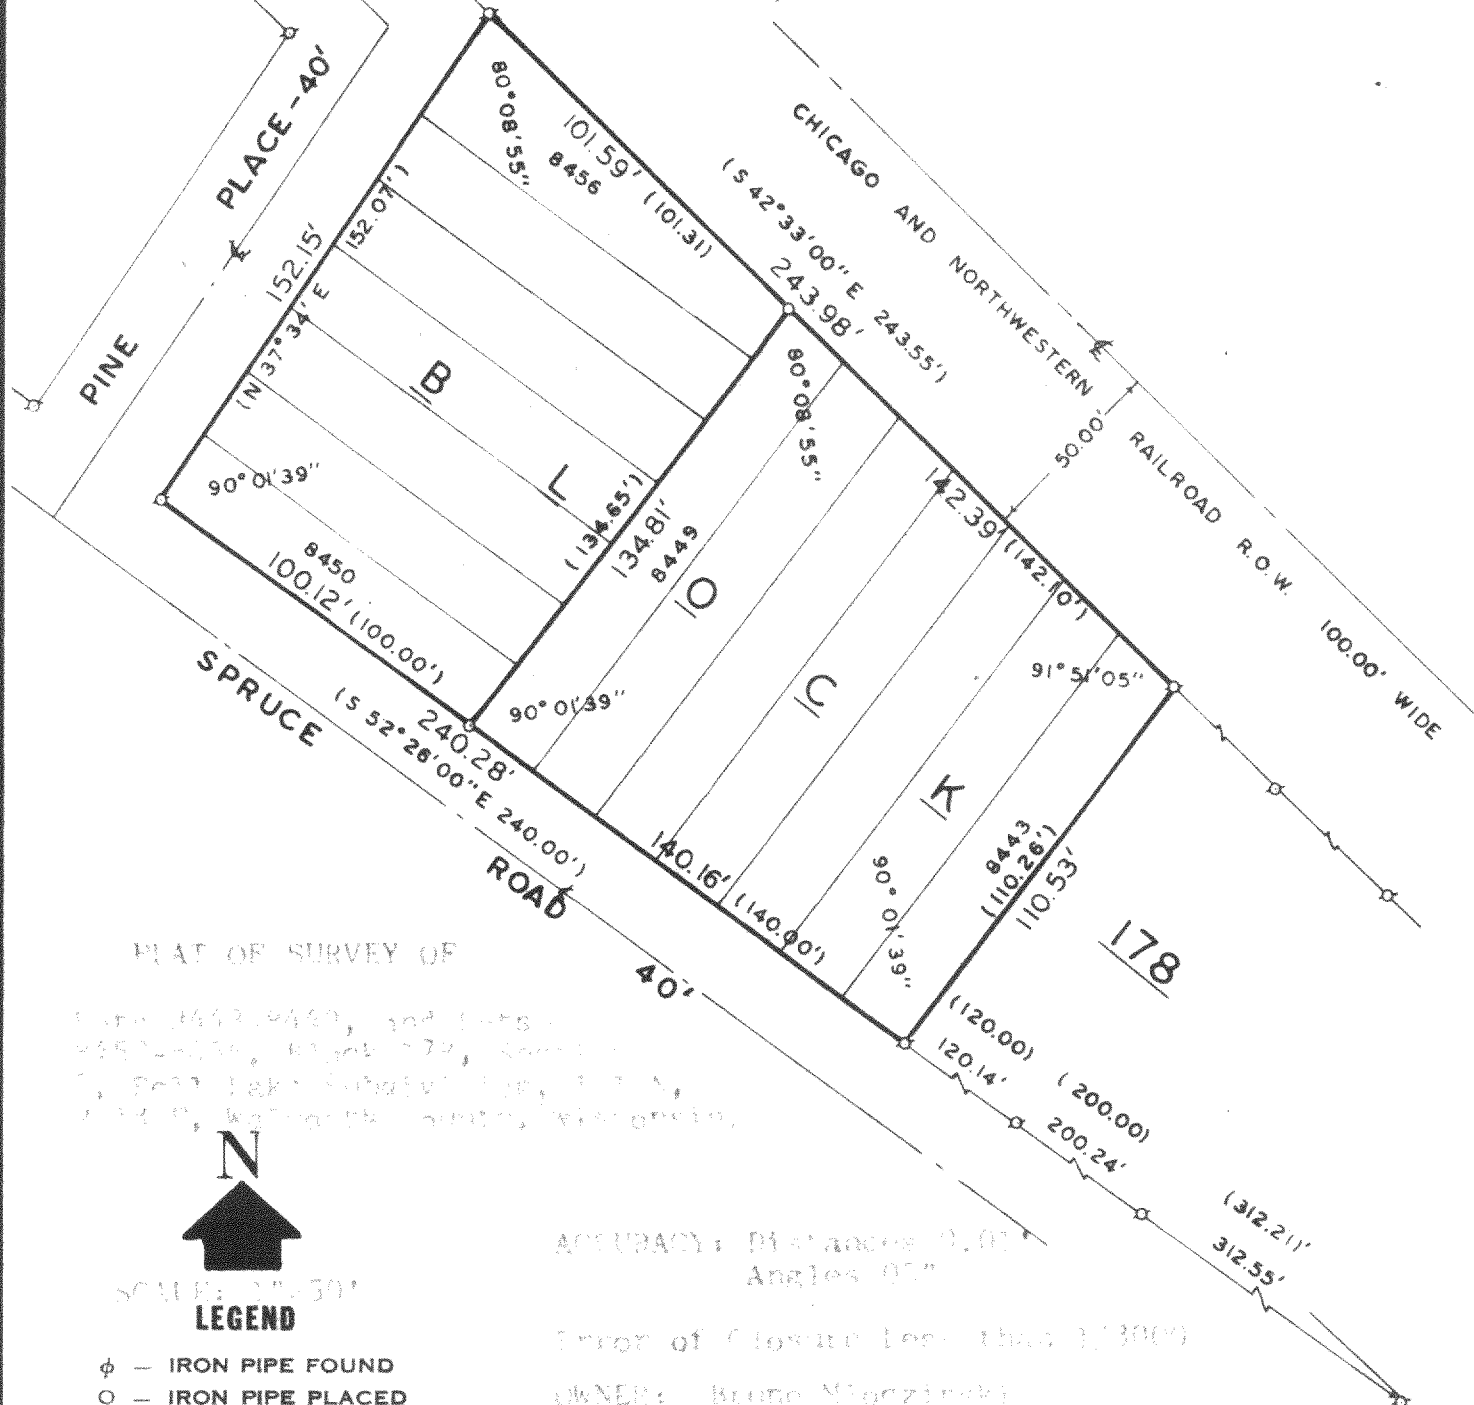

PLAT OF SURVEY OF


Sections 14, 15, 16, 17, and 18, T. 1 N., R. 1 E., S. 1 W., Lake Geneva, Wis., and the Chicago and Northwestern Railroad, Lake Geneva, Wisconsin.



SCALE: 1"=50'
LEGEND

- φ — IRON PIPE FOUND
- — IRON PIPE PLACED
- — CONCRETE MONUMENT
- x — SPIKE

(1) As Platted

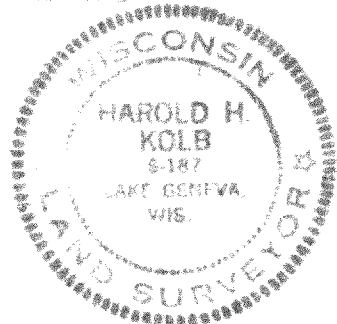

ACCURACY: Distances 0.01'
Angles 05"

Error of Closure less than 1/3000

OWNER: Bruno Mazurkiewicz

I, HAROLD H. KOLB, DO HEREBY CERTIFY THAT I HAVE SURVEYED THE PROPERTY HEREON DESCRIBED ACCORDING TO THE OFFICIAL RECORDS, AND THAT THE PLAT HEREON IS A CORRECT REPRESENTATION OF THE LOT LINES.

Harold H. Kolb

HAROLD H. KOLB
WISCONSIN REGISTERED LAND SURVEYOR, S-187

DATE Feb. 5, 1975

MPL-1692
1694

118-478