

PLAT OF SURVEY
OF

LOTS 5851, 5852, 5853 & 5854, PELL LAKE SUBDIVISION, UNIT NO. 4, LOCATED IN SECTION 15,
T. 1 N., R. 18 E. of the 4TH P.M., TOWNSHIP OF BLOOMFIELD, COUNTY OF WALWORTH, WISCONSIN.

I HEREBY CERTIFY THAT I HAVE SURVEYED THE LAND DESCRIBED ABOVE AND THAT THE PLAT DRAWN
HEREON IS A CORRECT REPRESENTATION OF SAID SURVEY. I FURTHER CERTIFY THAT THE DWELLING
ON SAID LAND IS LOCATED AS SHOWN ON THIS PLAT.



SCALE 1" = 20'

o = IRON PIPE STAKE

BEARINGS ARE THOSE OF RECORDED PLAT.

FOR: HAROLD FOREMAN.

John F. Degen 3-27-75
JOHN F. DEGEN, LAND SURVEYOR #242
589 N. PINE ST., BURLINGTON, WISC.

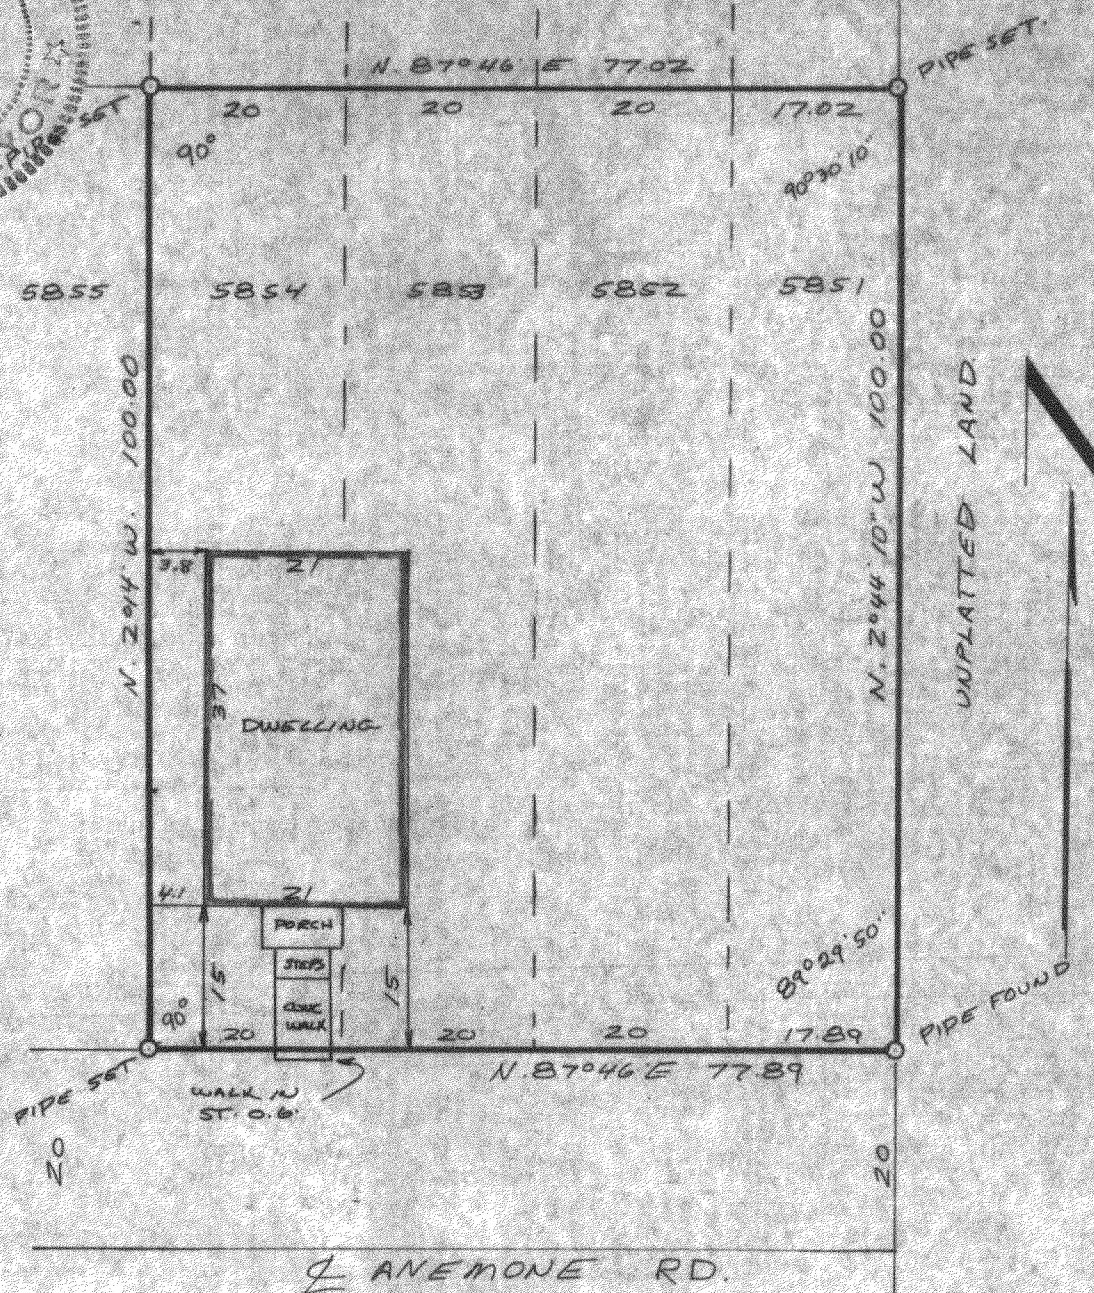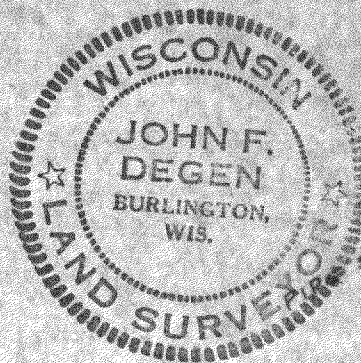

118-483