


HAROLD H. KOLB

REGISTERED PROFESSIONAL LAND SURVEYOR
LAKE GENEVA, WISCONSIN

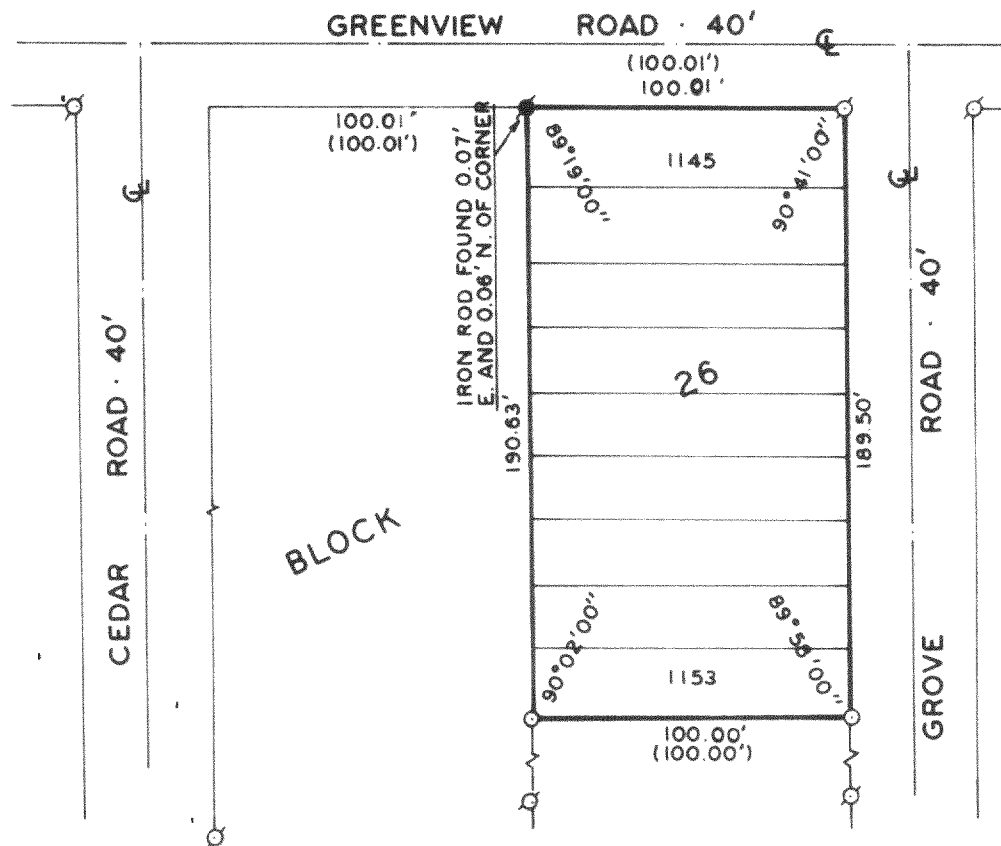

PLAT OF SURVEY OF

LOTS 1145-1153, BLOCK 26, SECTION 1
OF PELL LAKE SUBDIVISION, T1N, R18E,
WALWORTH COUNTY, WISCONSIN.

OWNER: MRS. WAGNER


ACCURACY: DISTANCES $\pm 0.01'$
ANGLES $\pm 05''$
ERROR OF CLOSURE LESS
THAN $1/3000$.

N

SCALE: 1" = 60'
LEGEND

- ϕ — IRON PIPE FOUND
- O — IRON PIPE PLACED
- $\bullet$ — IRON ROD FOUND
- x — SPIKE

() — AS PLATTED

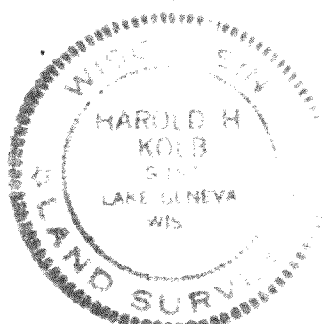

I, HAROLD H. KOLB, DO HEREBY CERTIFY THAT I HAVE
SURVEYED THE PROPERTY HEREON DESCRIBED ACCORDING
TO THE OFFICIAL RECORDS, AND THAT THE PLAT HEREON
IS A CORRECT REPRESENTATION OF THE LOT LINES.

Harold H. Kolb
HAROLD H. KOLB
WISCONSIN REGISTERED LAND SURVEYOR, S-187
DATE June 30, 1975

118-485