



PLAT OF SURVEY
OF
LOTS 16 & 17, BLOCK 1, OF THE 8TH ADDITION TO NIPPERSINK PARK, A SUBDIVISION
LOCATED IN SECTION 24, T. 1 N., R. 18 E. OF THE 4TH P.M., TOWNSHIP OF BLOOMFIELD,
WALWORTH COUNTY, WISCONSIN.

FOR: LEO NOWAK

SCALE 1" = 30'

o = IRON STAKE FOUND OR SET AS NOTED ON PLAT

BEARINGS ARE RELATIVE TO THE ROAD LINE WHICH WAS USED AS PLATTED AS N.30°44' W.

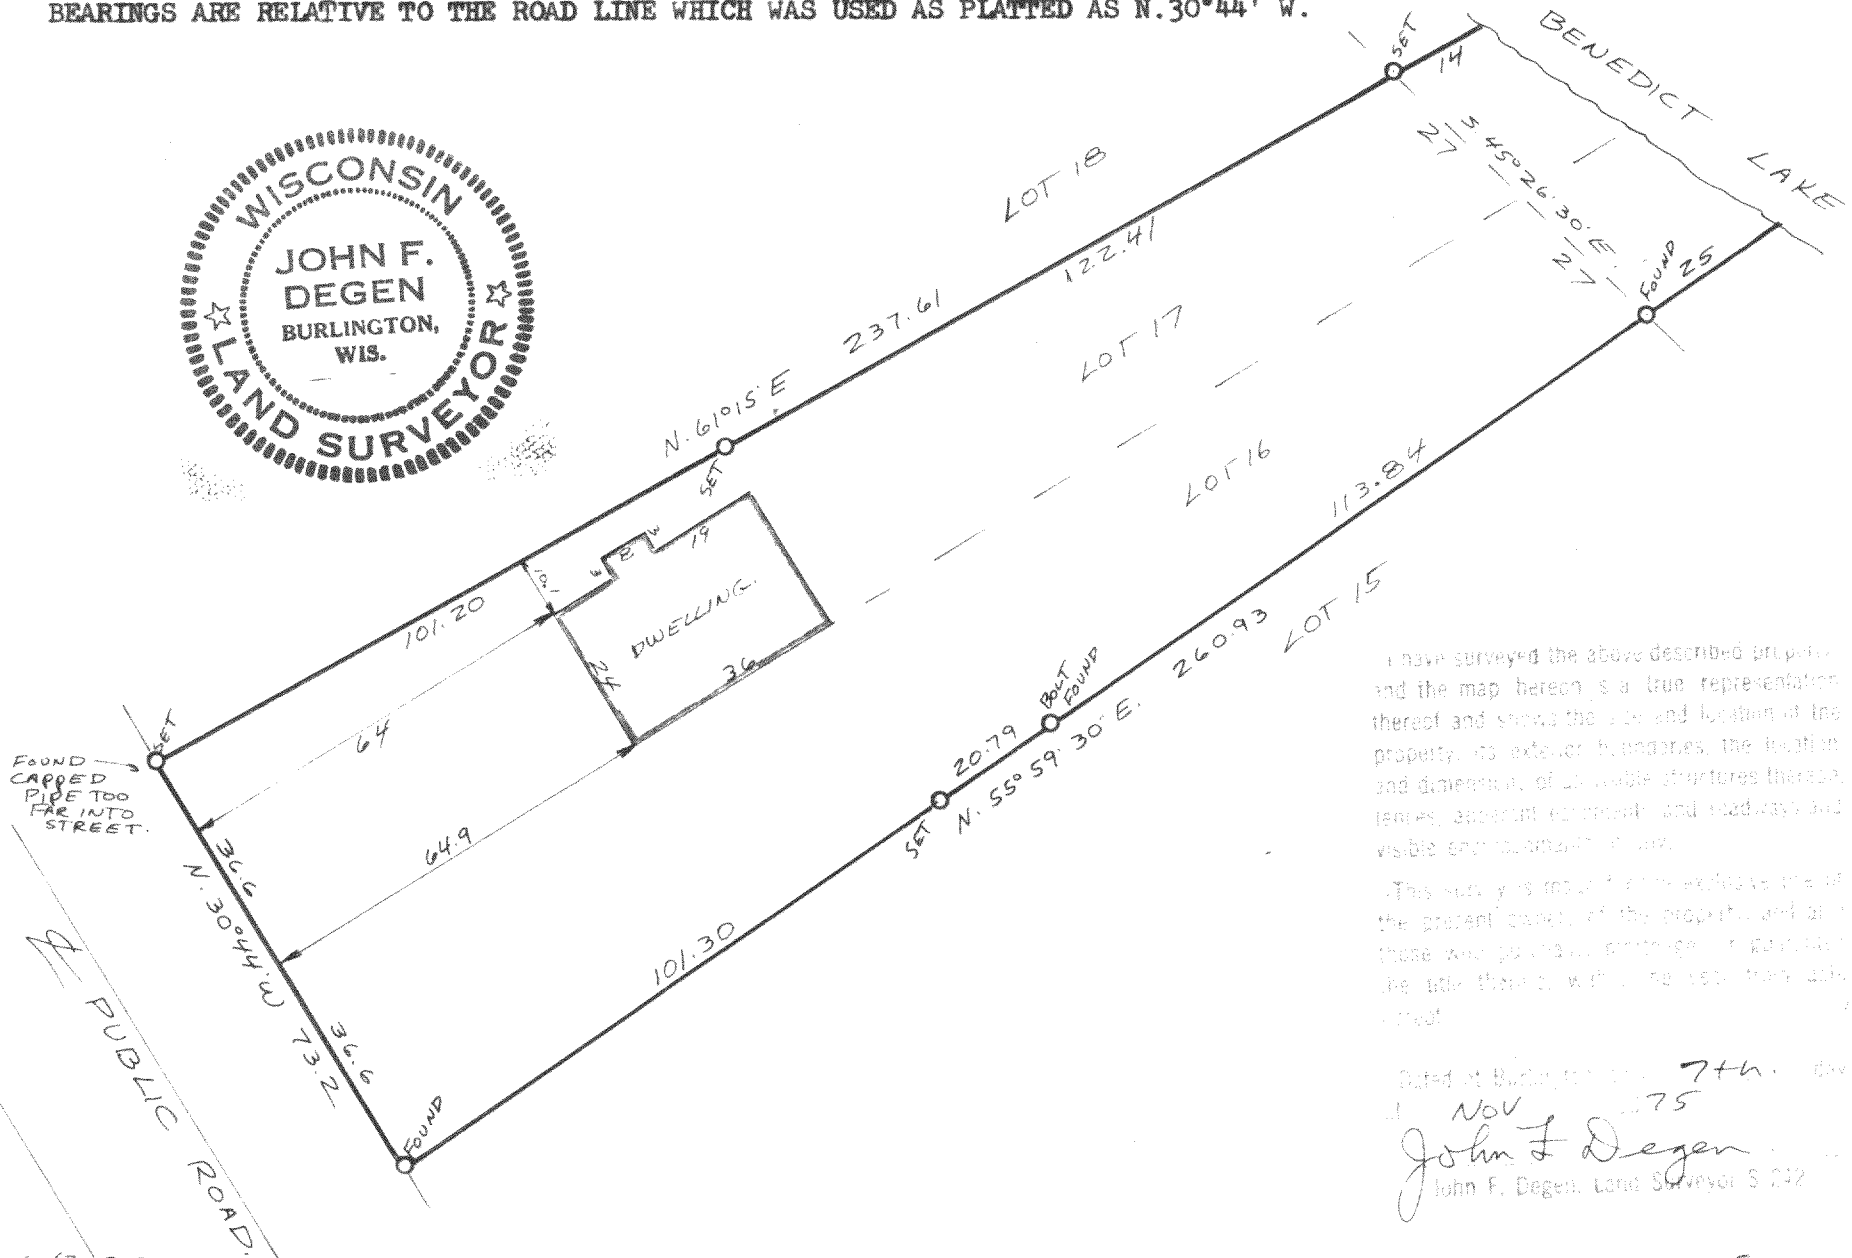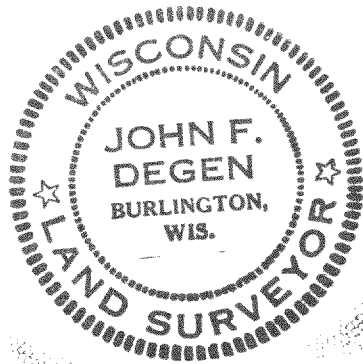

I have surveyed the above described property and the map hereon is a true representation thereof and shows the size and location of the property, its exterior boundaries, the location and dimensions of all visible structures thereon, fences, adjacent corners and roadways and visible encroachments, if any.

This survey is made from evidence of the present corner of the property and of those who paid for the same, and is subject to the title thereof, which may hereafter be corrected.

Dated at Burlington, Wis., 7th day of Nov 1975
John F. Degen
John F. Degen, Land Surveyor S 242