


LOTS 48 & 49, BLOCK 1, OF THE 8TH ADDITION TO SHINNER'S NIPPERSINK PARK, A SUBDIVISION OF PART OF SECTION 24,
T. 1 N., R. 18 E. OF THE 4TH P.M., TOWNSHIP OF BLOOMFIELD, COUNTY OF WALWORTH, STATE OF WISCONSIN.

○ = IRON PIPE STAKE FOUND OR SET AS NOTED ON PLAT

FOR: ROBERT MICHELS.

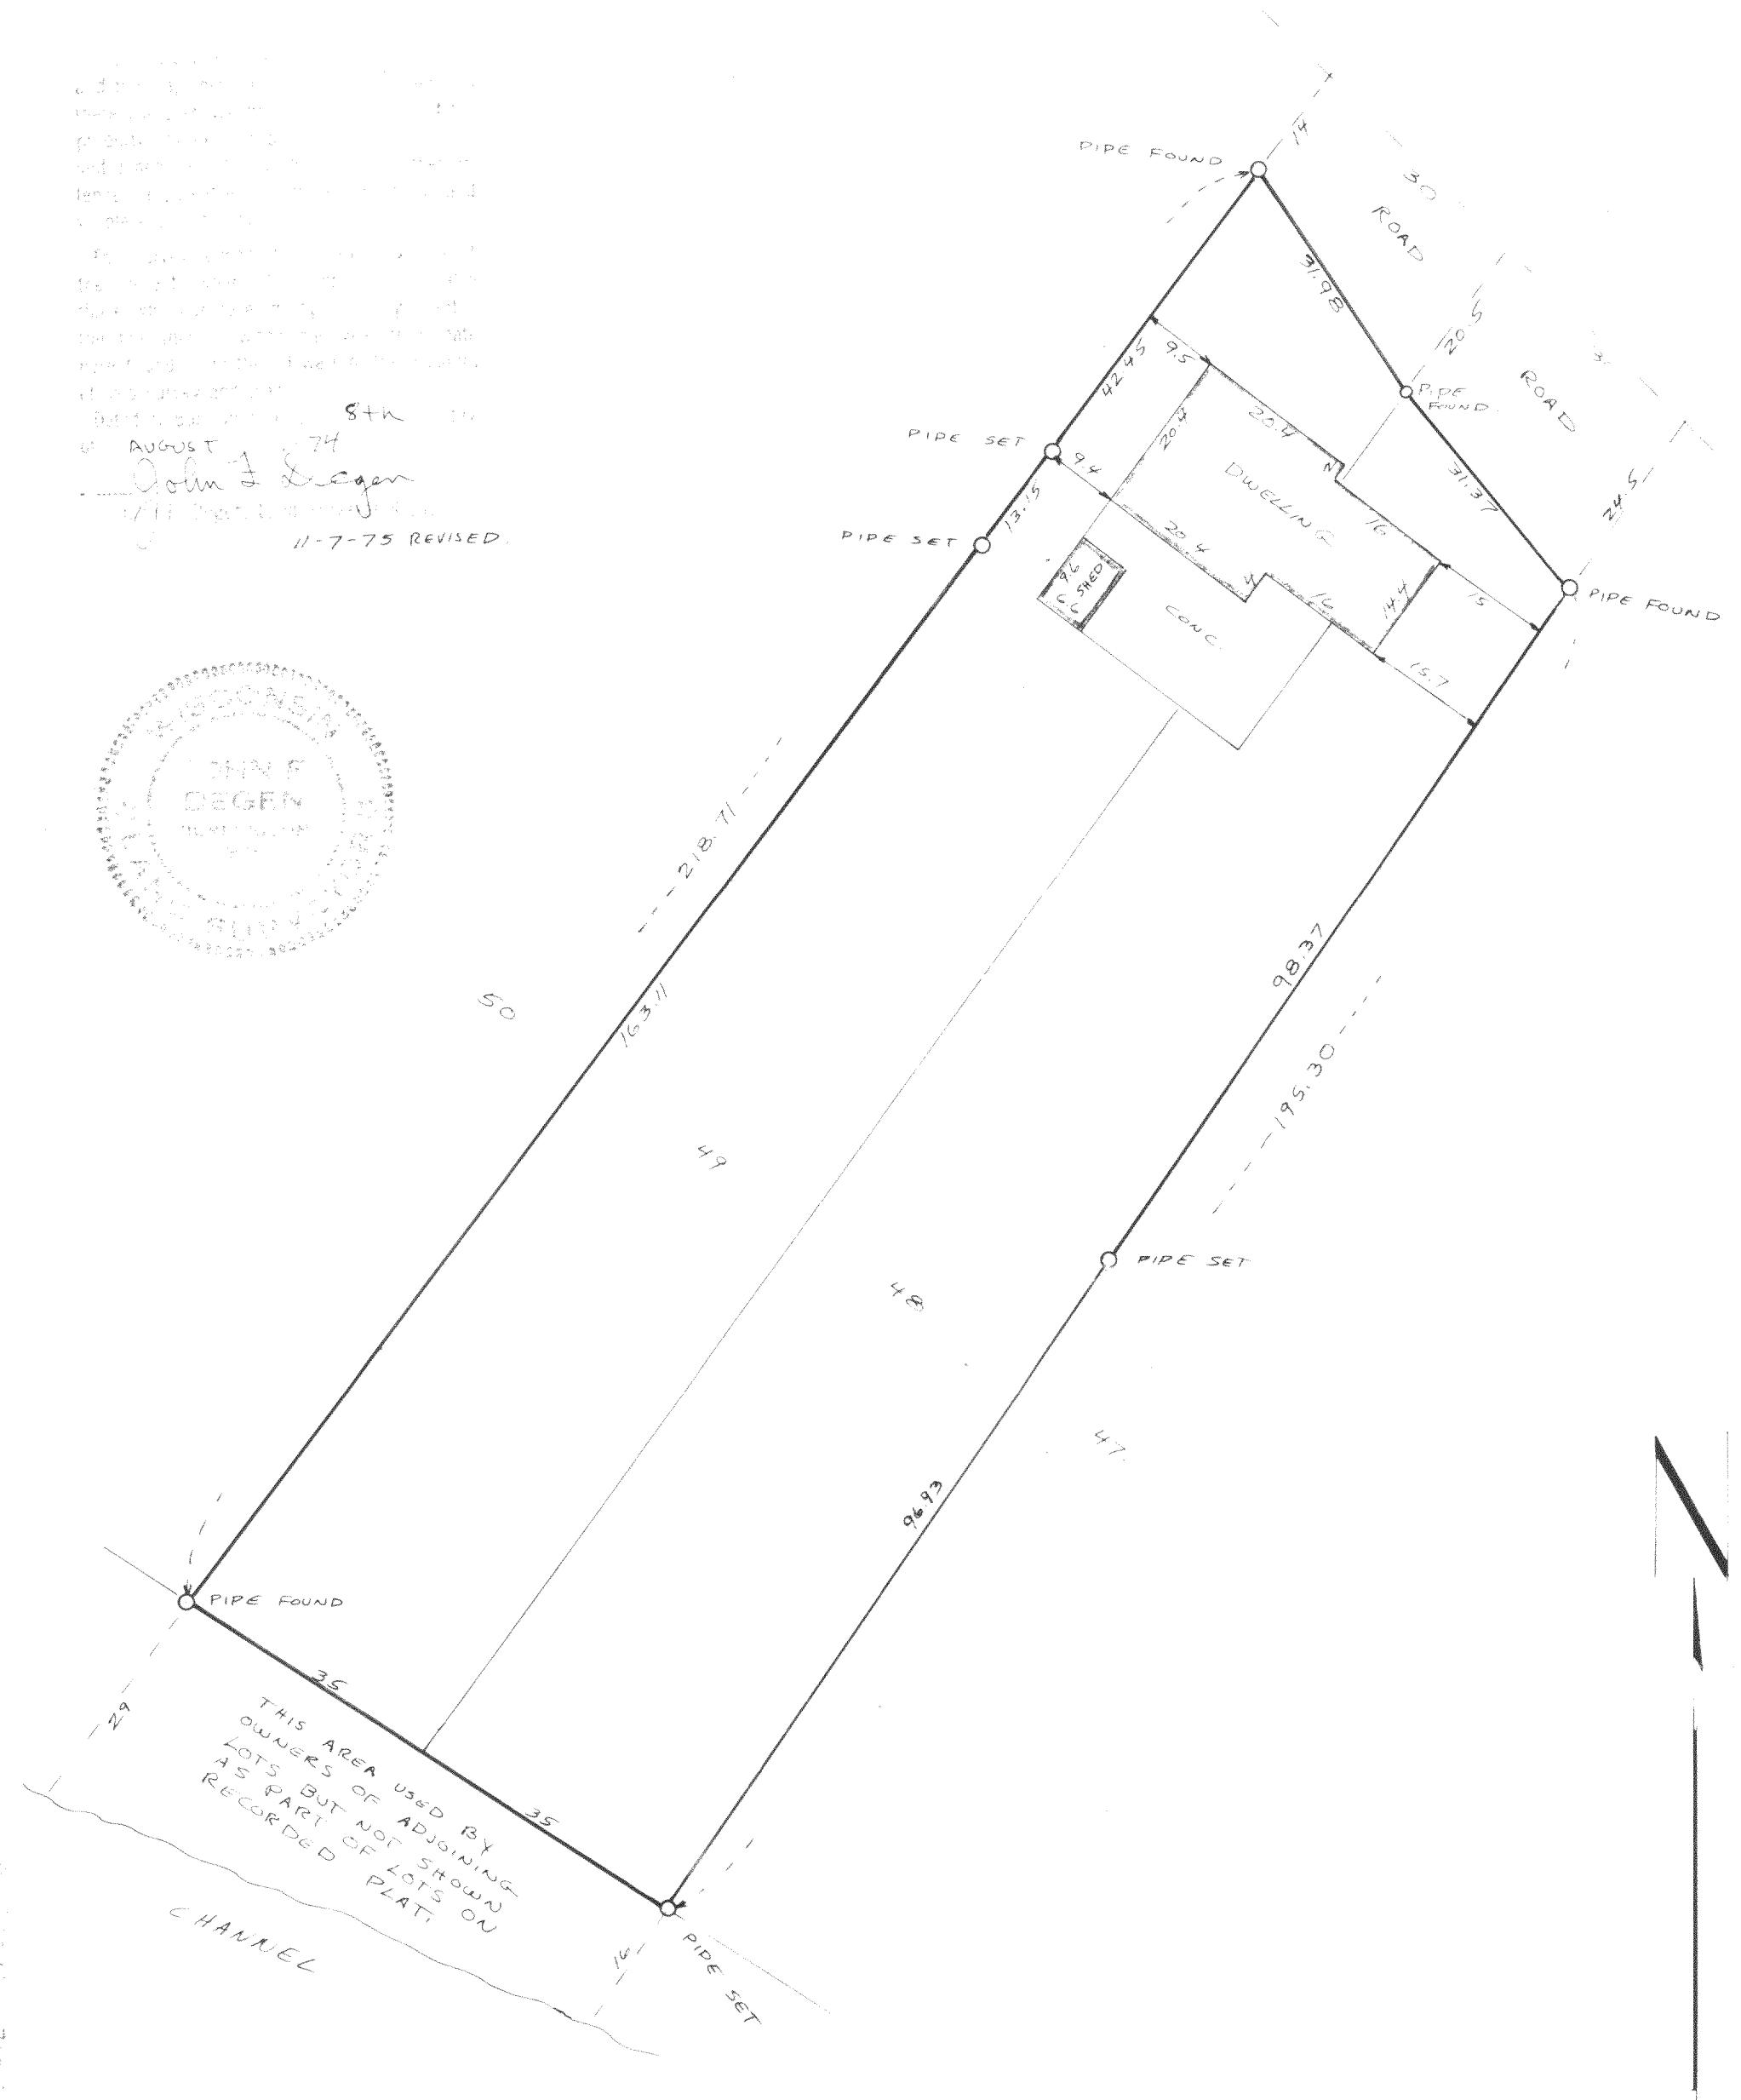

m n p s s - s a

REVISED 11-7-75 TO SHOW REMOVAL OF ENCROACHMENTS

118-501