

HAROLD H. KOLB

REGISTERED PROFESSIONAL LAND SURVEYOR
LAKE GENEVA, WISCONSIN

PLAT OF SURVEY OF

THE EAST 1/2 OF LOTS 9 AND 16
AND LOTS 8 AND 17, BLOCK 1,
SHINNER'S 3RD ADDITION TO
NIPPERSINK PARK, SECTION 24,
T1N, R18E, WALWORTH COUNTY,
WISCONSIN.

ACCURACY: DISTANCE $\pm 0.01'$
ANGLES $\pm 05''$
ERROR OF CLOSURE
LESS THAN 1/3000

OWNER: LOUIS LEVIN

I hereby certify that I have surveyed
the above described property and that
the above map is a true representation
thereof and shows the size and location
of the property, its exterior bound-
aries, the location of all visible
structures and dimensions of all prin-
cipal buildings thereon, boundary

fences, apparent easements and roadways and visible
encroachments, if any.

This survey is made for the use of the present owners
of the property, and also those who purchase, mortgage,
or guarantee the title within one (1) year from date
hereof.


I, HAROLD H. KOLB, DO HEREBY CERTIFY THAT I HAVE
SURVEYED THE PROPERTY HEREON DESCRIBED ACCORDING
TO THE OFFICIAL RECORDS, AND THAT THE PLAT HEREON
IS A CORRECT REPRESENTATION OF THE LOT LINES.

HAROLD H. KOLB
WISCONSIN REGISTERED LAND SURVEYOR, S-187
DATE Sept. 22, 1975

REVISED: SEPTEMBER 26, 1975

REVISED: OCTOBER 14, 1975

118-502

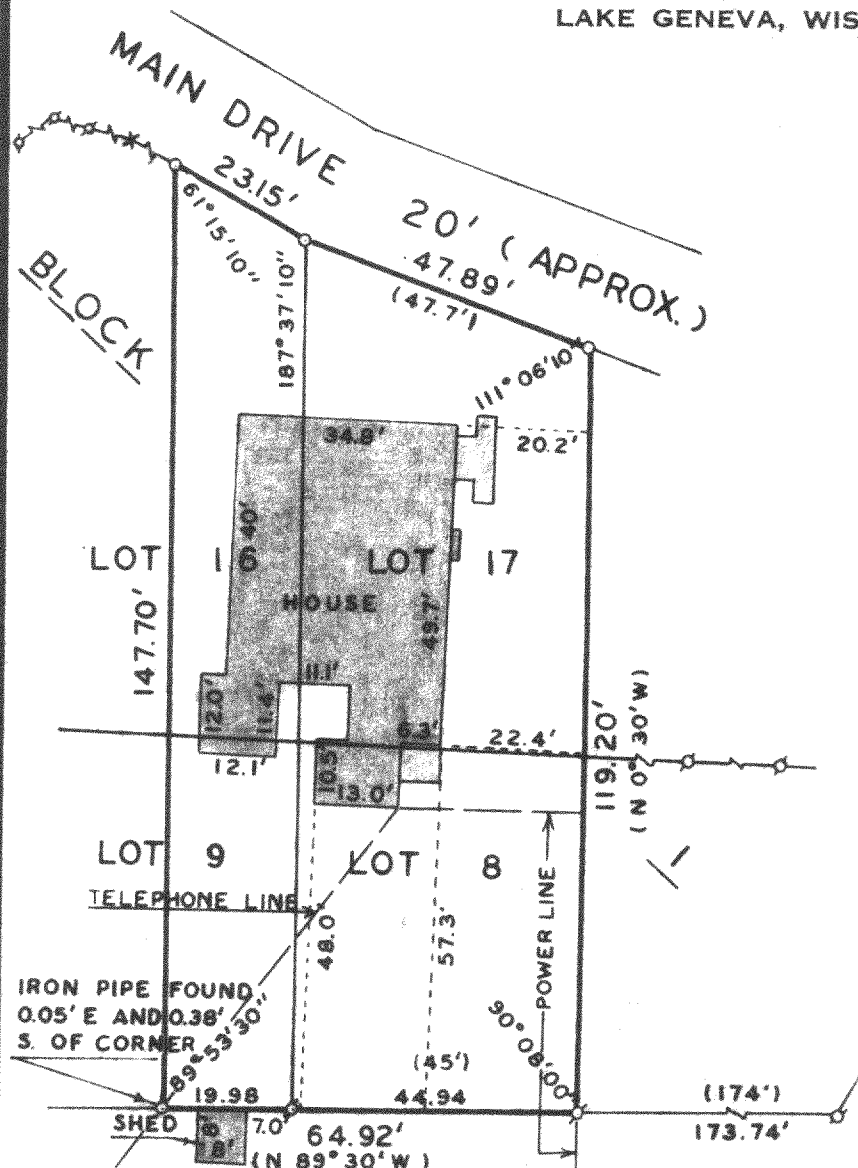

N
SCALE: 1" = 30'
LEGEND

- φ — IRON PIPE FOUND
- — IRON PIPE PLACED
- — CONCRETE MONUMENT
- x — SPIKE
- () — AS PLATTED



NPS-3-33
" 3-39