


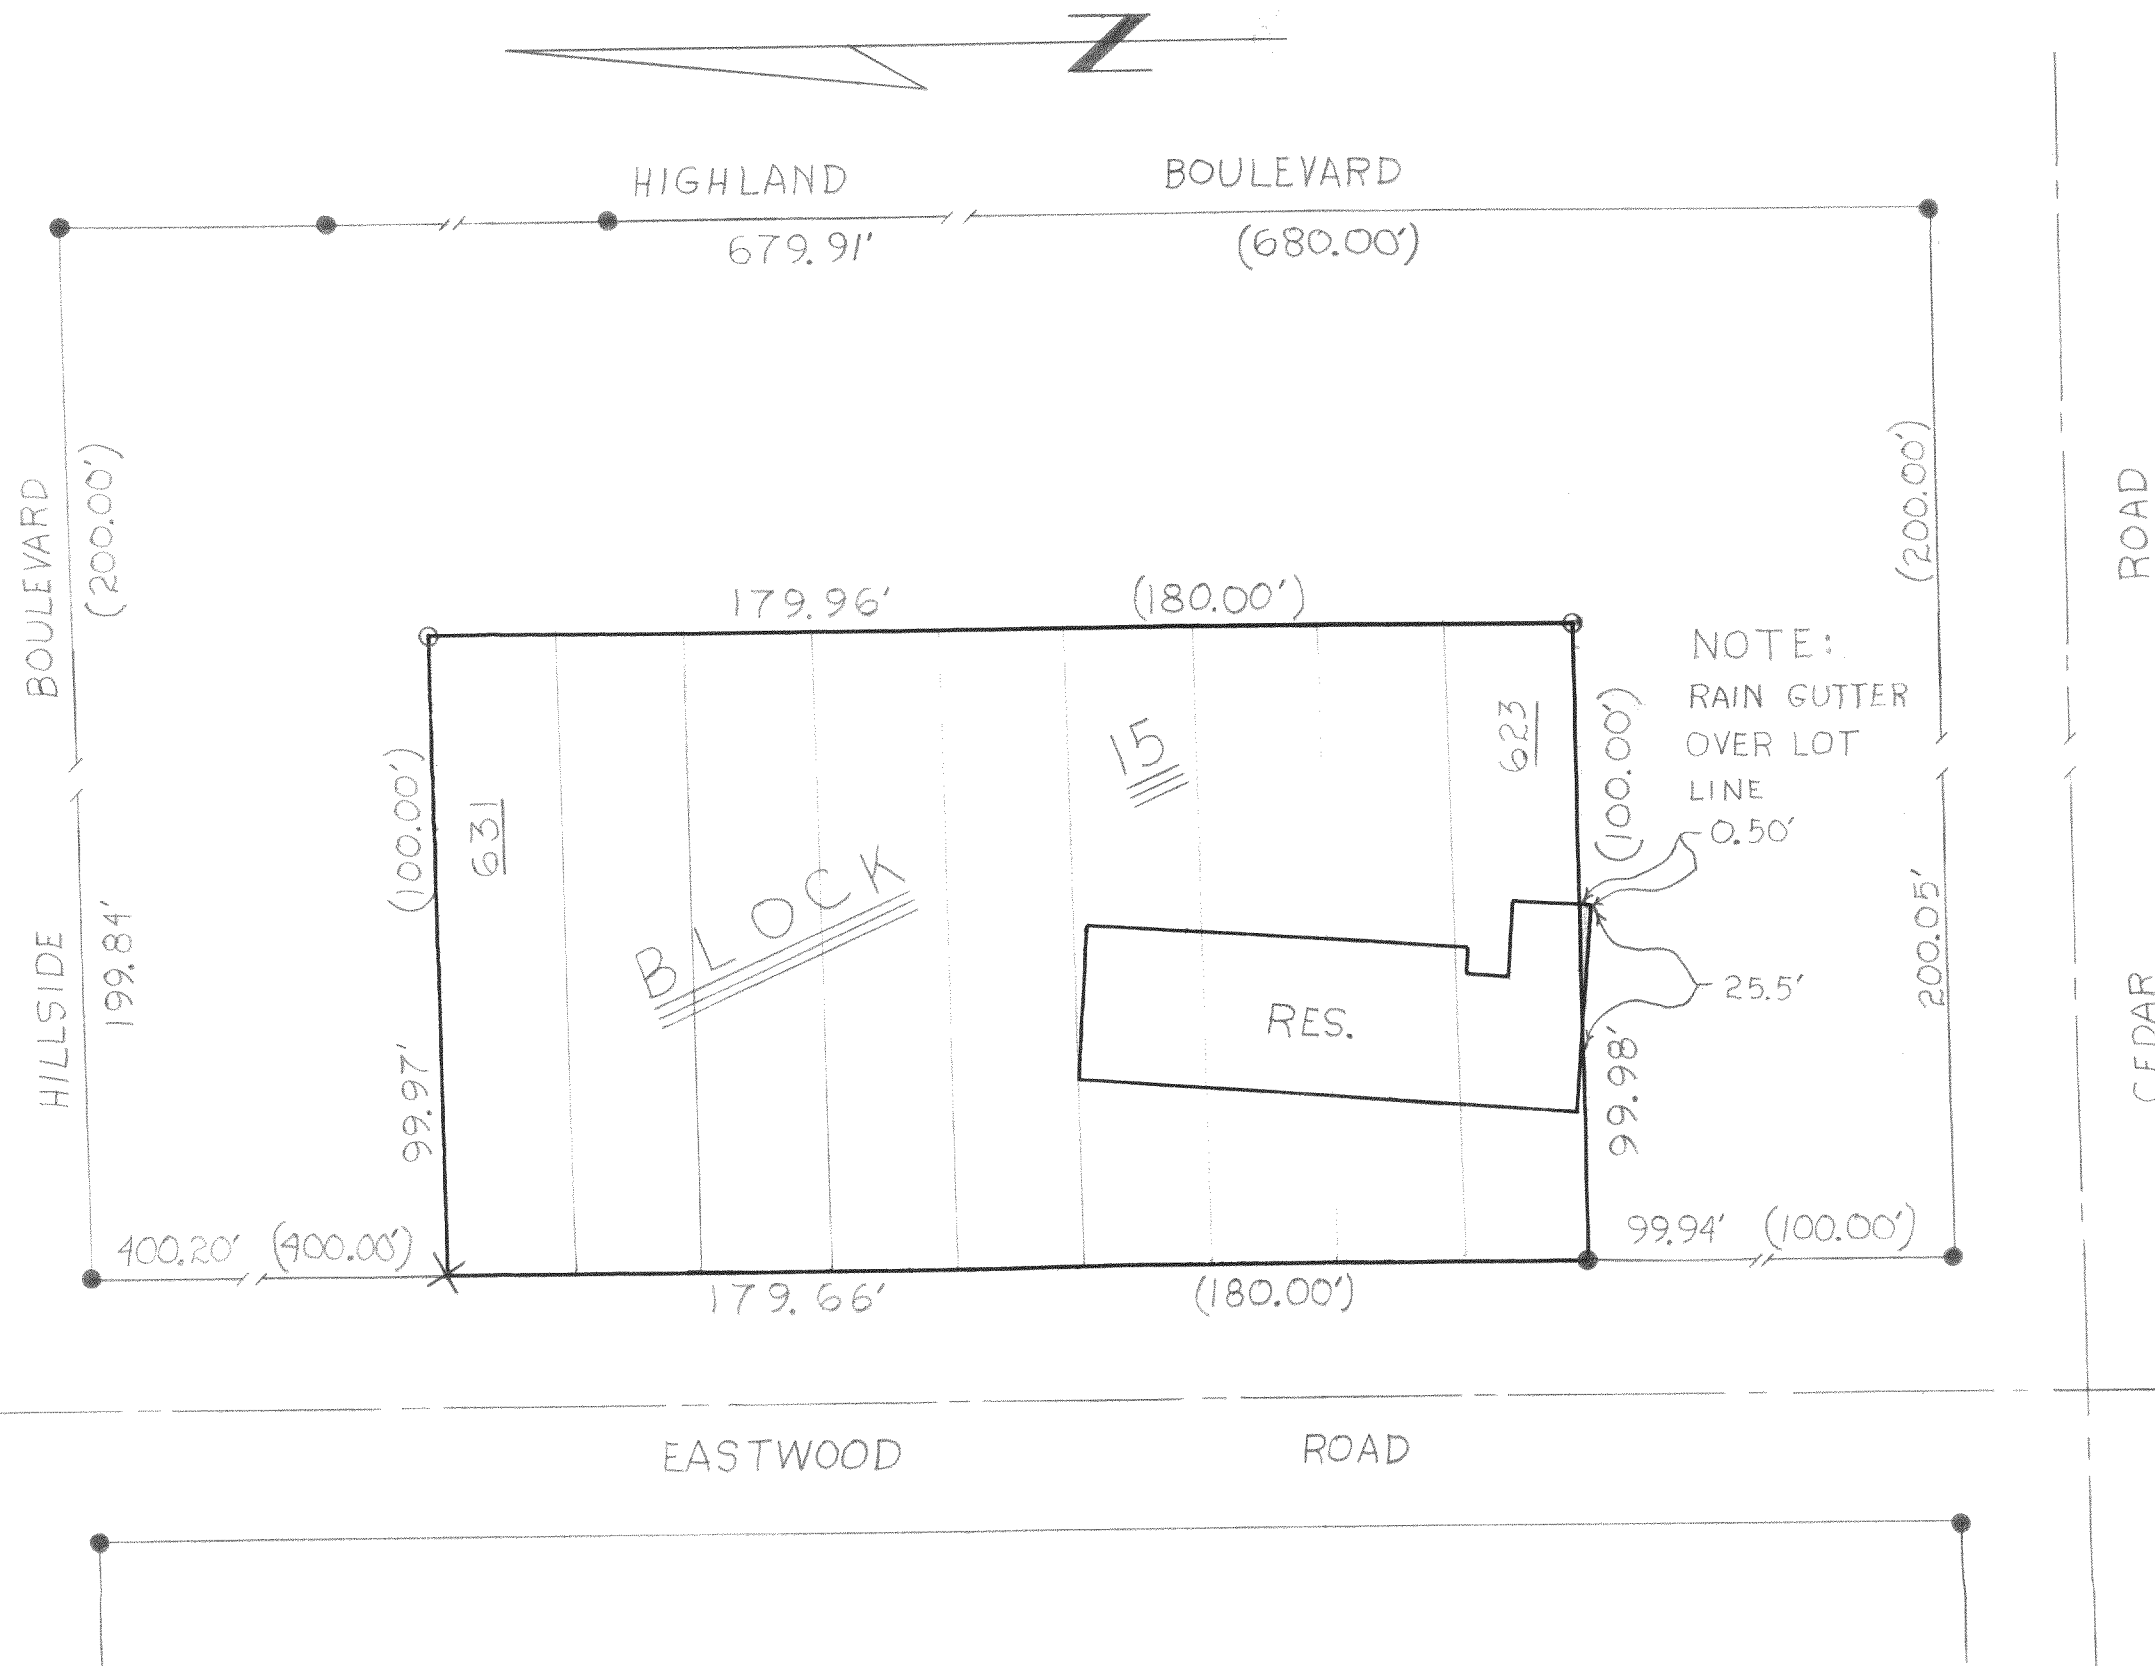

DESCRIPTION:
 LOTS 623 THRU 631
 BLOCK 15, PELL LAKE
 HIGHLANDS, T.1N, R.18E,
 WALWORTH COUNTY,
 WISCONSIN.


LEGEND
 ● IRON PIPE FOUND
 ○ IRON PIPE SET
 X IRON ROD FOUND
 () RECORDED AS

DATE: SEPTEMBER 26, 1975

CERTIFICATE:

I, JOSEPH M. BIAGI, SURVEYOR, DO HEREBY CERTIFY
 THAT I HAVE SURVEYED THE LANDS HEREON DESCRIBED.

Joseph M. Biagi
 JOSEPH M. BIAGI R.L.S.#12

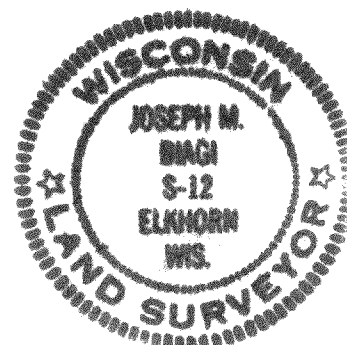

REVISIONS			MERTON FARMER		
NO.	DATE	BY			
1			LOT 623-631, BLOCK 15, PELL LAKE HIGHLANDS T.1N. R.18 E.		
2					
3			DRAWN BY HWG	SCALE 1"=30'	MATERIAL
4			CHK'D	DATE 9-26-75	DRAWING NO.
5			TRACED	APP'D	#99-75

118-50 B