

ROBERS & BOYD, INC.
CONSULTING ENGINEERS & LAND SURVEYORS



PHONE (414) 763-2652

116 E. CHESTNUT ST.

BURLINGTON, WIS. 53105

PLAT OF SURVEY

Lots 662 and 663 in Block 15 of Pell Lake Highlands, Bloomfield Township,
Walworth County, Wisconsin.

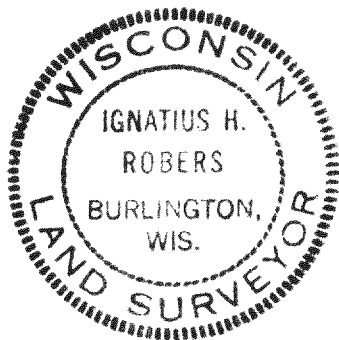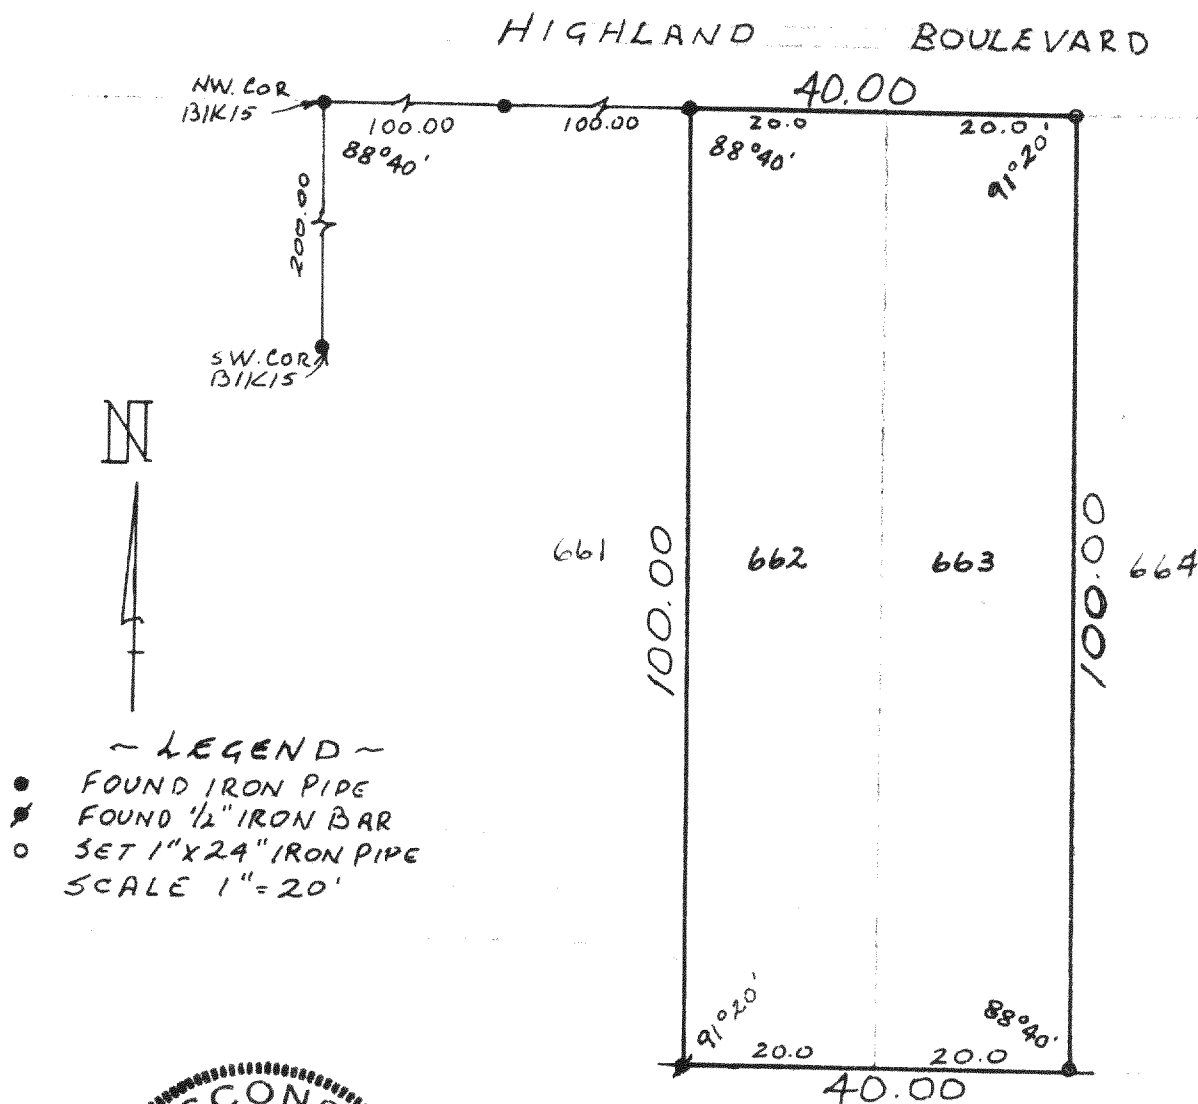

I HEREBY CERTIFY THAT WE HAVE SURVEYED THE LANDS DESCRIBED
ABOVE, ACCORDING TO OFFICIAL RECORDS, AND THAT THE PLAT
DRAWN HEREON IS A CORRECT REPRESENTATION OF SAID SURVEY.

WIS. REG. LAND SURVEYOR

DATE 3-22-76

JOB NO. 76040