


GEORGE T. DUNHAM
SURVEYING & SUBDIVIDING
DELAVER, WISCONSIN

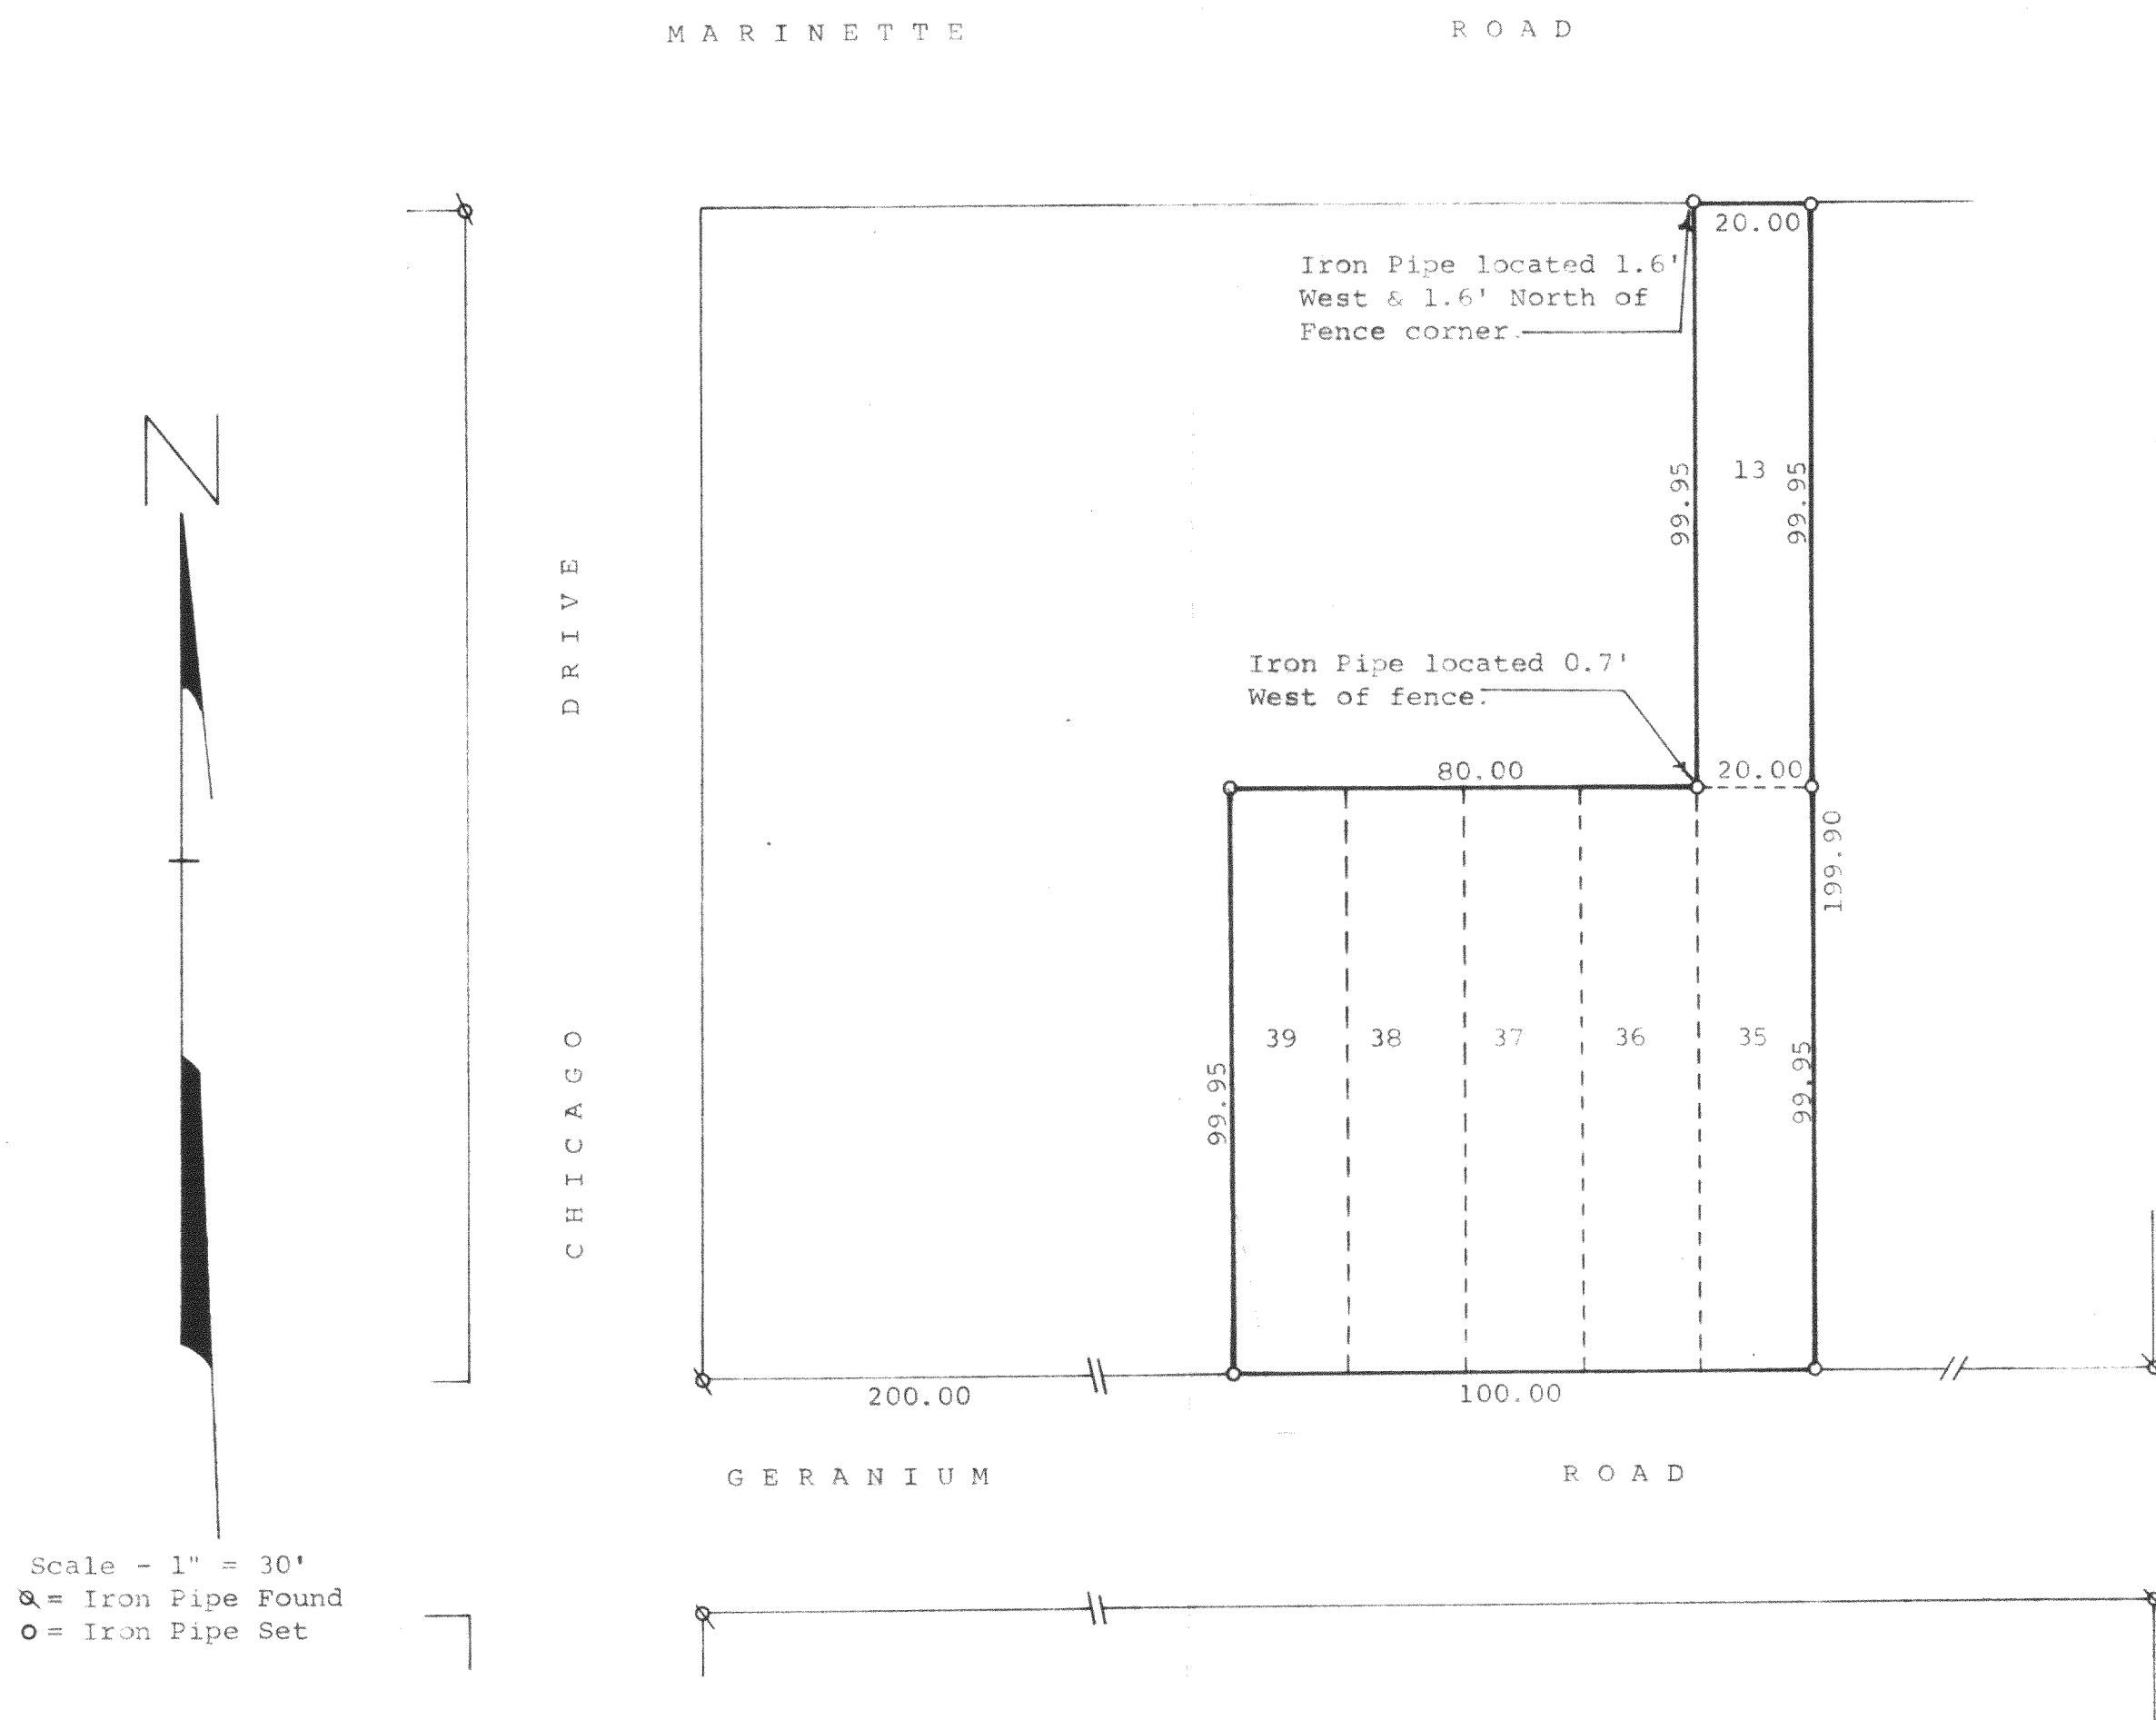

Plat of survey of Lots 13, 35, 36, 37, 38, & 39,
Block 1 of Pell Lake Addition, a subdivision
located in Sections 14 and 23, T 1 N, R 18 E,
Walworth County, Wisconsin.
February 11, 1976

George T. Dunham
George T. Dunham, Surveyor

