


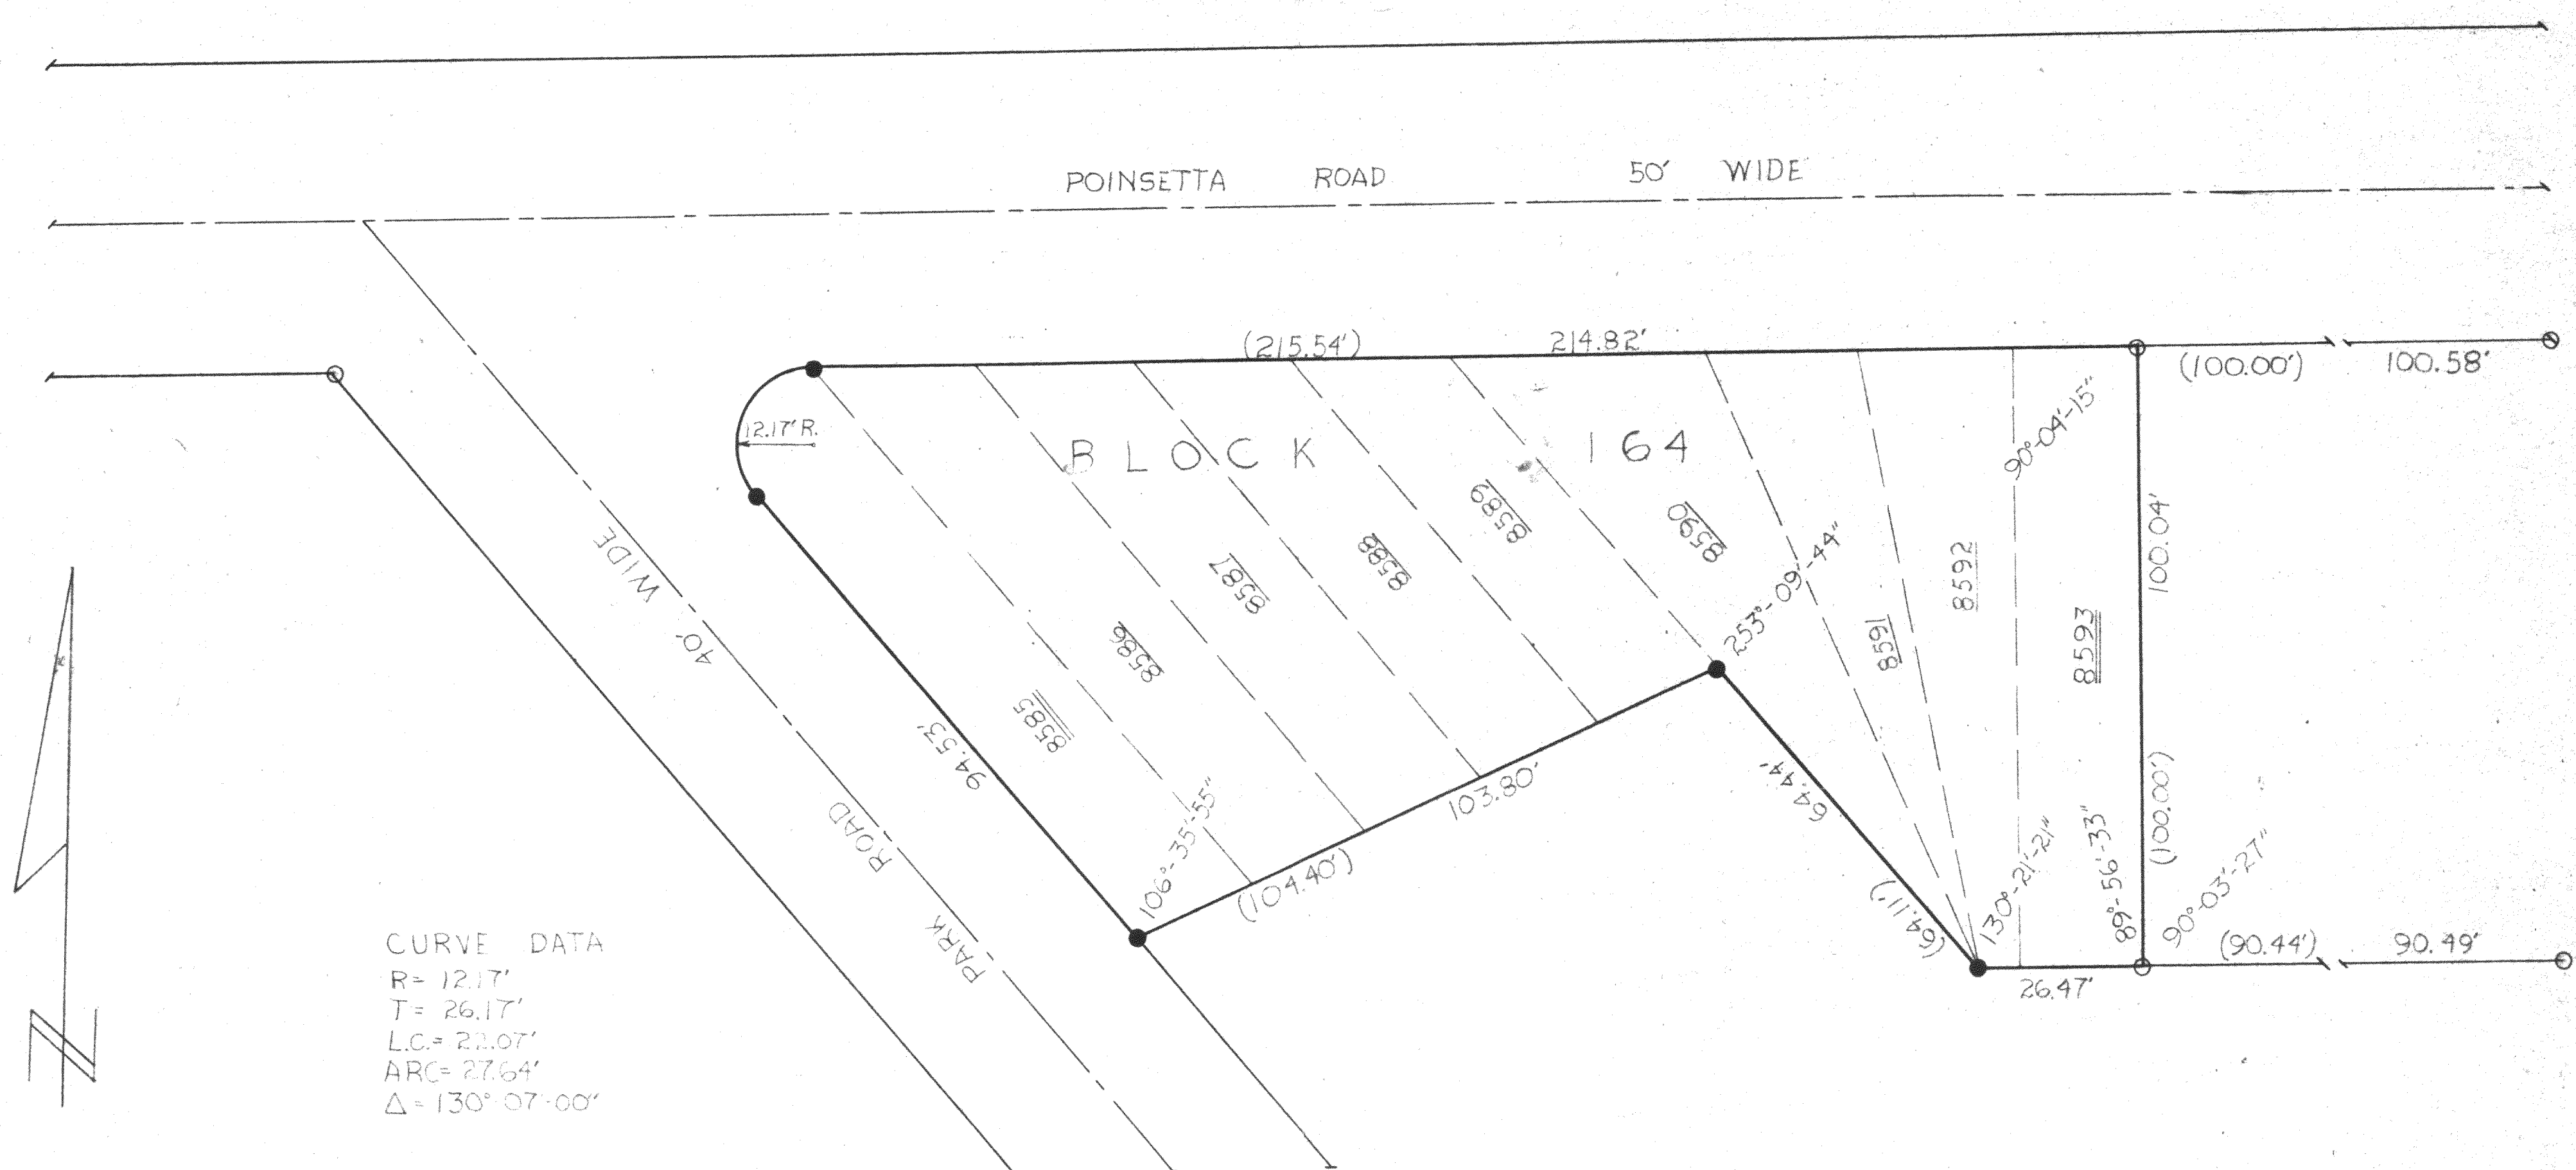

CURVE DATA
 R= 12.17'
 T= 26.17'
 L.C.= 22.07'
 ARC= 27.64'
 Δ= 130° 07' 00"

DESCRIPTION:

LOTS 8585 THRU 8593, BLOCK 164, PELL LAKE SUBDIVISION,
 LOCATED IN SECTION 5, TOWN 1 NORTH, RANGE 18 EAST,
 WALWORTH COUNTY, WISCONSIN.

DATE: FEBRUARY 10, 1976


LEGEND

- IRON PIPE FOUND
- IRON PIPE SET
- () RECORDED AS

CERTIFICATE:

I, JOSEPH M. BIAGI, SURVEYOR, DO HEREBY CERTIFY
 THAT I HAVE SURVEYED THE LANDS HEREON DESCRIBED.

Joseph M. Biagi
 JOSEPH M. BIAGI R.L.S.#12

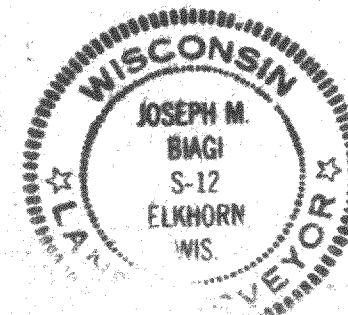

REVISIONS			CASMIR JOCEFIK		
NO.	DATE	BY	LOTS 8585-8593, BLOCK 164, PELL LAKE SEC 5 T. 1 N. R. 18 E.		
1			DRAWN BY	HWG	SCALE 1"=20'
2			CHK'D	DATE 2-10-76	DRAWING NO.
3			TRACED	APP'D	#7-76
4					
5					