

HAROLD H. KOLB

REGISTERED PROFESSIONAL LAND SURVEYOR
LAKE GENEVA, WISCONSIN

PLAT OF SURVEY OF

LOTS 8368-8374, BLOCK 177, SECTION 5,
PELL LAKE SUBDIVISION, T1N, R18E, WALWORTH
COUNTY, WISCONSIN.

ACCURACY: DISTANCES: $\pm 0.01'$
ANGLES: $\pm$
ERROR OF CLOSURE: LESS THAN ONE PART IN
3,000

ORDERED BY: RICHARD J. RECZYNSKI

ROAD - 49.5' WIDE

CLOVER

261.30'


BLOCK

FENCE 1.0' W.
OF IRON PIPE

N

SCALE: 1" = 50'
LEGEND

- φ - IRON PIPE FOUND
- O - IRON PIPE PLACED
- - CONCRETE MONUMENT
- x - SPIKE
- () - AS PLATTED

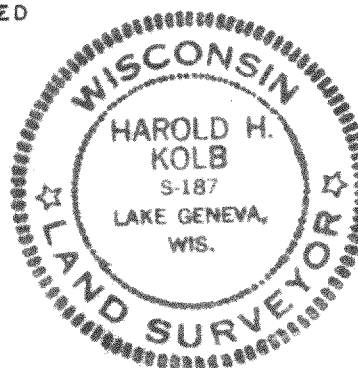

FENCE CORNER 1.2'S.
AND .2'E. OF IRON PIPE

(N 37°34'00"E)
100.00'
FENCE
8374

(S 52°26'00"E)
140.00'

177

WALNUT ROAD - 40' WIDE

(S 52°26'00"E)
140.00'

(N 37°34'00"E)
100.00'

8368

90°00'00"

200.00'

I, HAROLD H. KOLB, DO HEREBY CERTIFY THAT I HAVE
SURVEYED THE PROPERTY HEREON DESCRIBED ACCORDING
TO THE OFFICIAL RECORDS, AND THAT THE PLAT HEREON
IS A CORRECT REPRESENTATION OF THE LOT LINES.

Harold H. Kolb

HAROLD H. KOLB
WISCONSIN REGISTERED LAND SURVEYOR, S-187
DATE *May 12, 1976*

118-523