


REGISTERED PROFESSIONAL LAND SURVEYOR
LAKE GENEVA, WISCONSIN

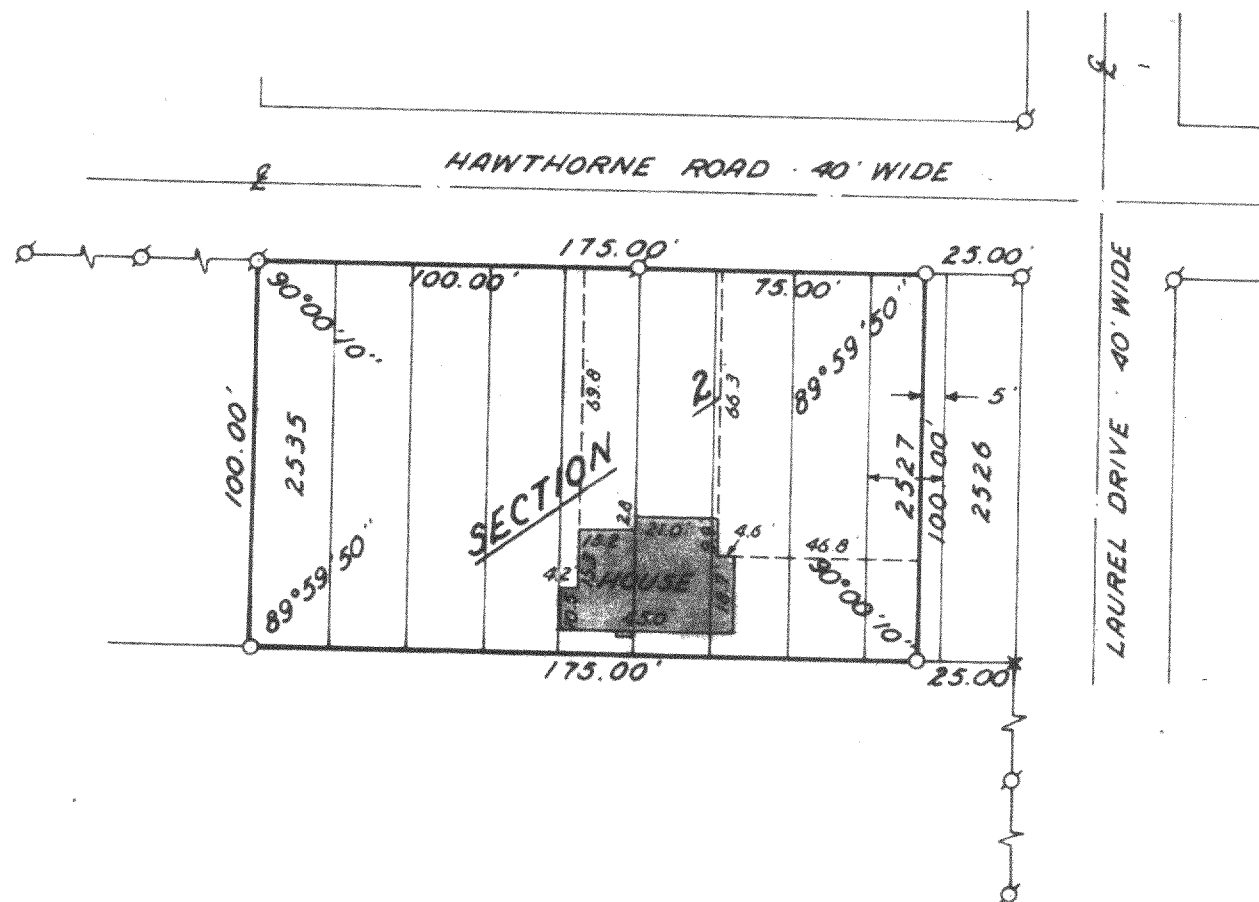

LOT 2527, EXCEPT THE EAST 5 FEET THERE-
OF, AND LOTS 2528-2535, SECTION 2, PELL
LAKE SUBDIVISION, T1N, R18E, WALWORTH
COUNTY, WISCONSIN.

OWNER: ANTHONY ROMANO


ACCURACY: DISTANCES: $\pm 0.01'$
 ANGLES: $\pm 05''$
 ERROR OF CLOSURE: LESS THAN
 ONE PART IN 3,000

I, HAROLD H. KOLB, DO HEREBY CERTIFY THAT I HAVE SURVEYED THE PROPERTY HEREON DESCRIBED ACCORDING TO THE OFFICIAL RECORDS, AND THAT THE PLAT HEREON IS A CORRECT REPRESENTATION OF THE LOT LINES, AND THE PRINCIPLE BUILDING LINES THEREON.

Harold H. Kohl

HAROLD H. KOLB
WISCONSIN REGISTERED LAND SURVEYOR, S-187

DATE Aug. 9, 1976

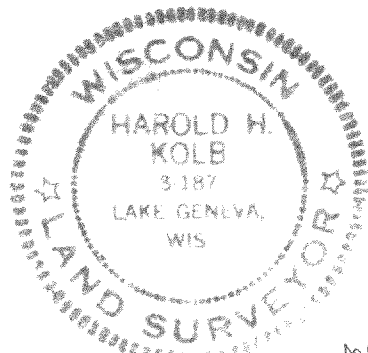

MPL-525

118-526