


#141 OK

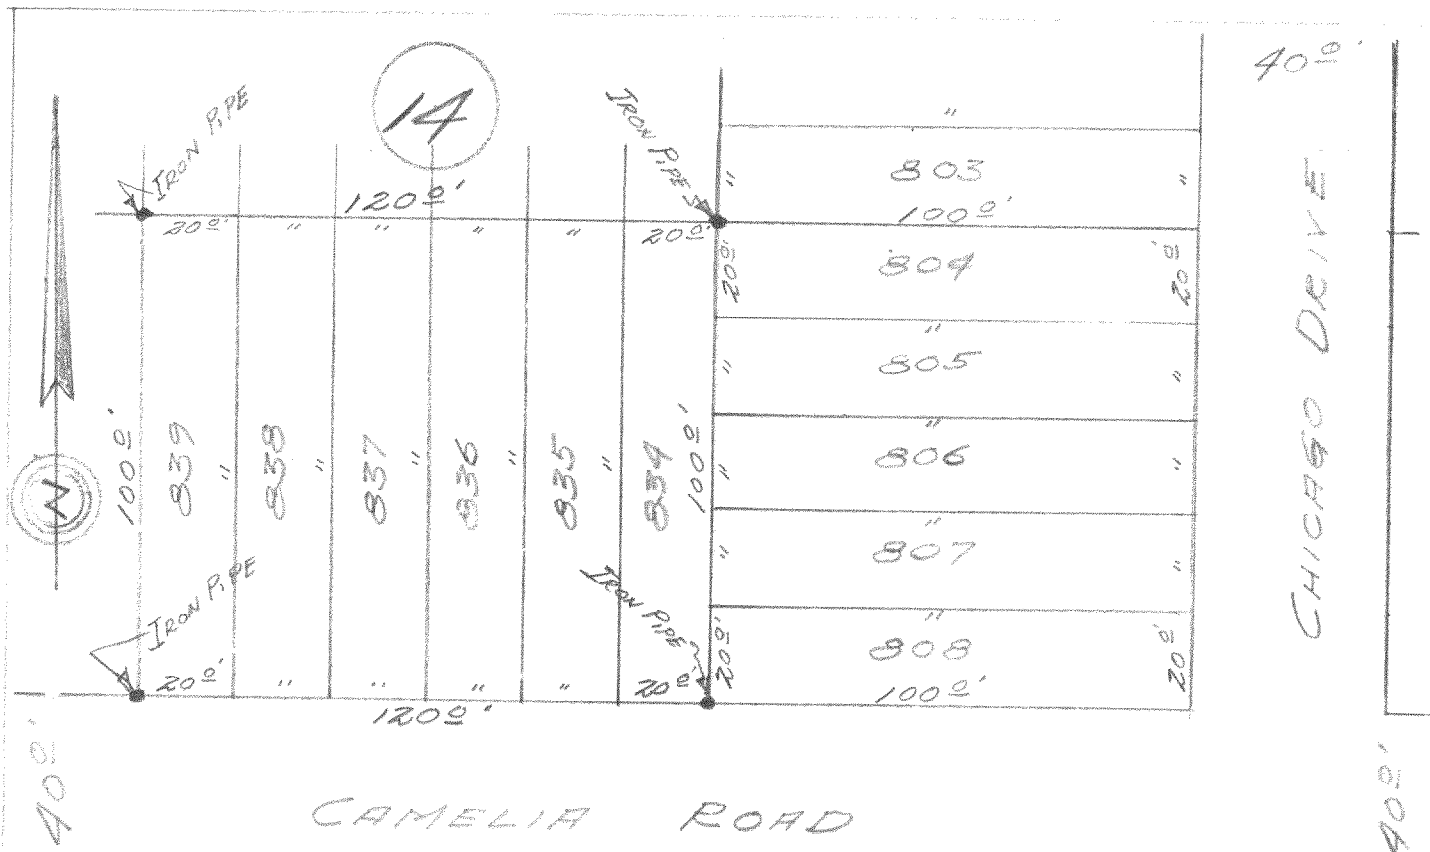

DESCRIPTION:


Lots 834 through 839, Block 14; Pell Lake Addition, of the West one-half of Sections 14 and 23, Town 1 north, Range 18 east of the 4th Principal Meridian, Bloomfield Township, Walworth County Wisconsin.

CERTIFICATE:

I, James F. Biagi, Surveyor do hereby certify that I, have on this the 31st day of July, 1962, surveyed the property hereon portrayed and described.

SIGNED AND SEALED ON THIS THE 1ST DAY OF AUGUST 1962.

James F. Biagi
James F. Biagi, RLS. 272
Elkhorn, Wisconsin.

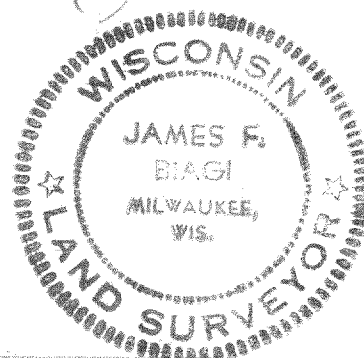

118-52B