

PLAT OF SURVEY
OF

LOTS 15 & 16, BLOCK 3, ROSE NIPPERSINK GARDENS, A SUBDIVISION OF PART OF
SECTION 24, T. 1 N., R. 18 E. OF THE 4TH P.M., TOWNSHIP OF BLOOMFIELD, COUNTY
OF WALWORTH, STATE OF WISCONSIN.

FOR: HARRY FAUST

SCALE 1" = 40'

○ = IRON PIPE STAKE

● = CONCRETE MONUMENT FOUND

BEARINGS ARE THOSE OF RECORDED PLAT.

LOTS ARE VACANT.

ALL CORNERS STAKES ARE MARKED WITH STAKES AS
SHOWN WITH IRON FENCE POSTS AS WITNESS.



I have surveyed the above-described property,
and the map hereon is a true representation
thereof and shows the size and location of the
property, its exterior boundaries, the location
and dimensions of all visible structures thereon,
fences, apparent easements and roadways and
visible encroachments, if any.

This survey is made for the exclusive use of
the present owners of the property, and also
those who purchase, mortgage, or guarantee
the title thereto, within one year from date
hereof.

Witnessed at Burlington, this 21ST day

SEPT 19 1976

John F. Degen
John F. Degen, Land Surveyor S 24E

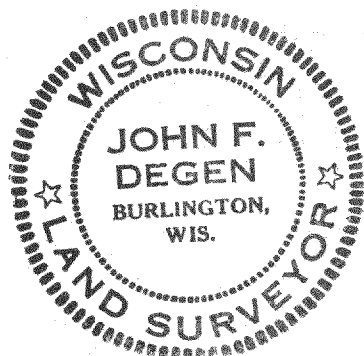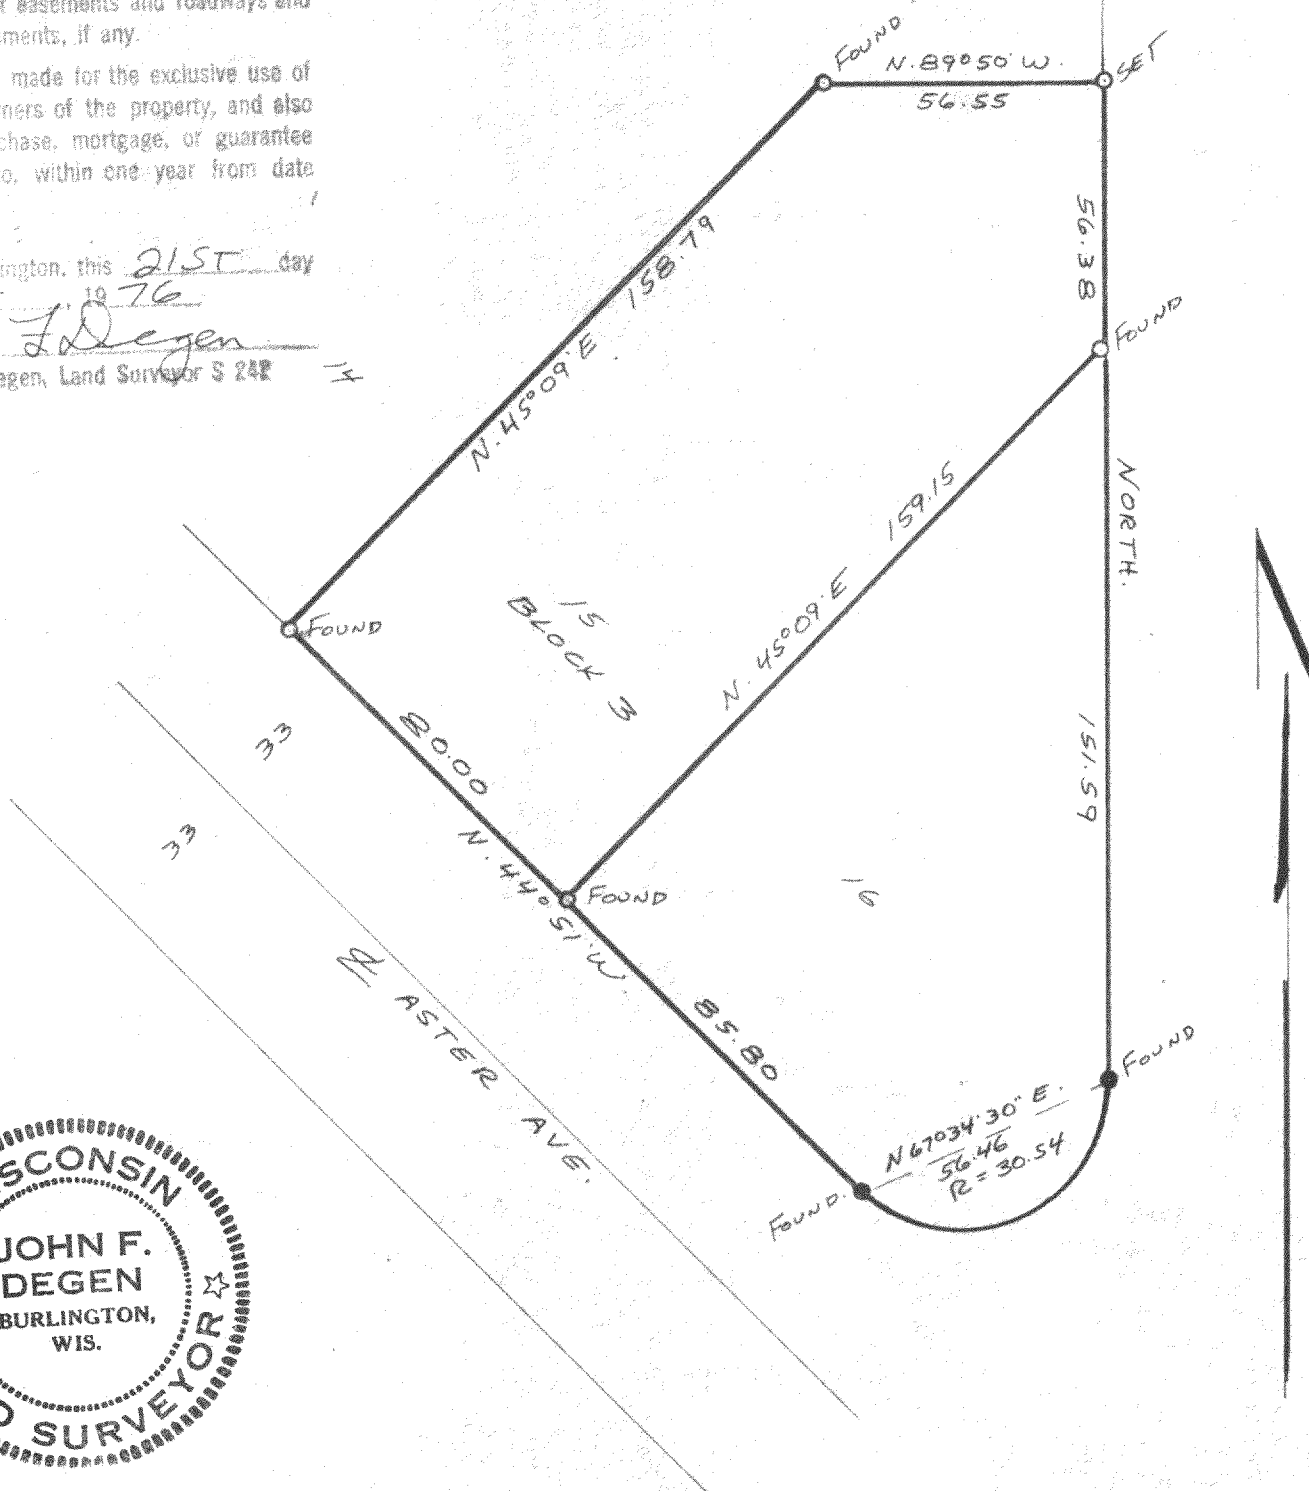

MRNG-25,26

118-533

DRAWER 6-D