


HAROLD H. KOLB
 REGISTERED PROFESSIONAL LAND SURVEYOR
 LAKE GENEVA, WISCONSIN

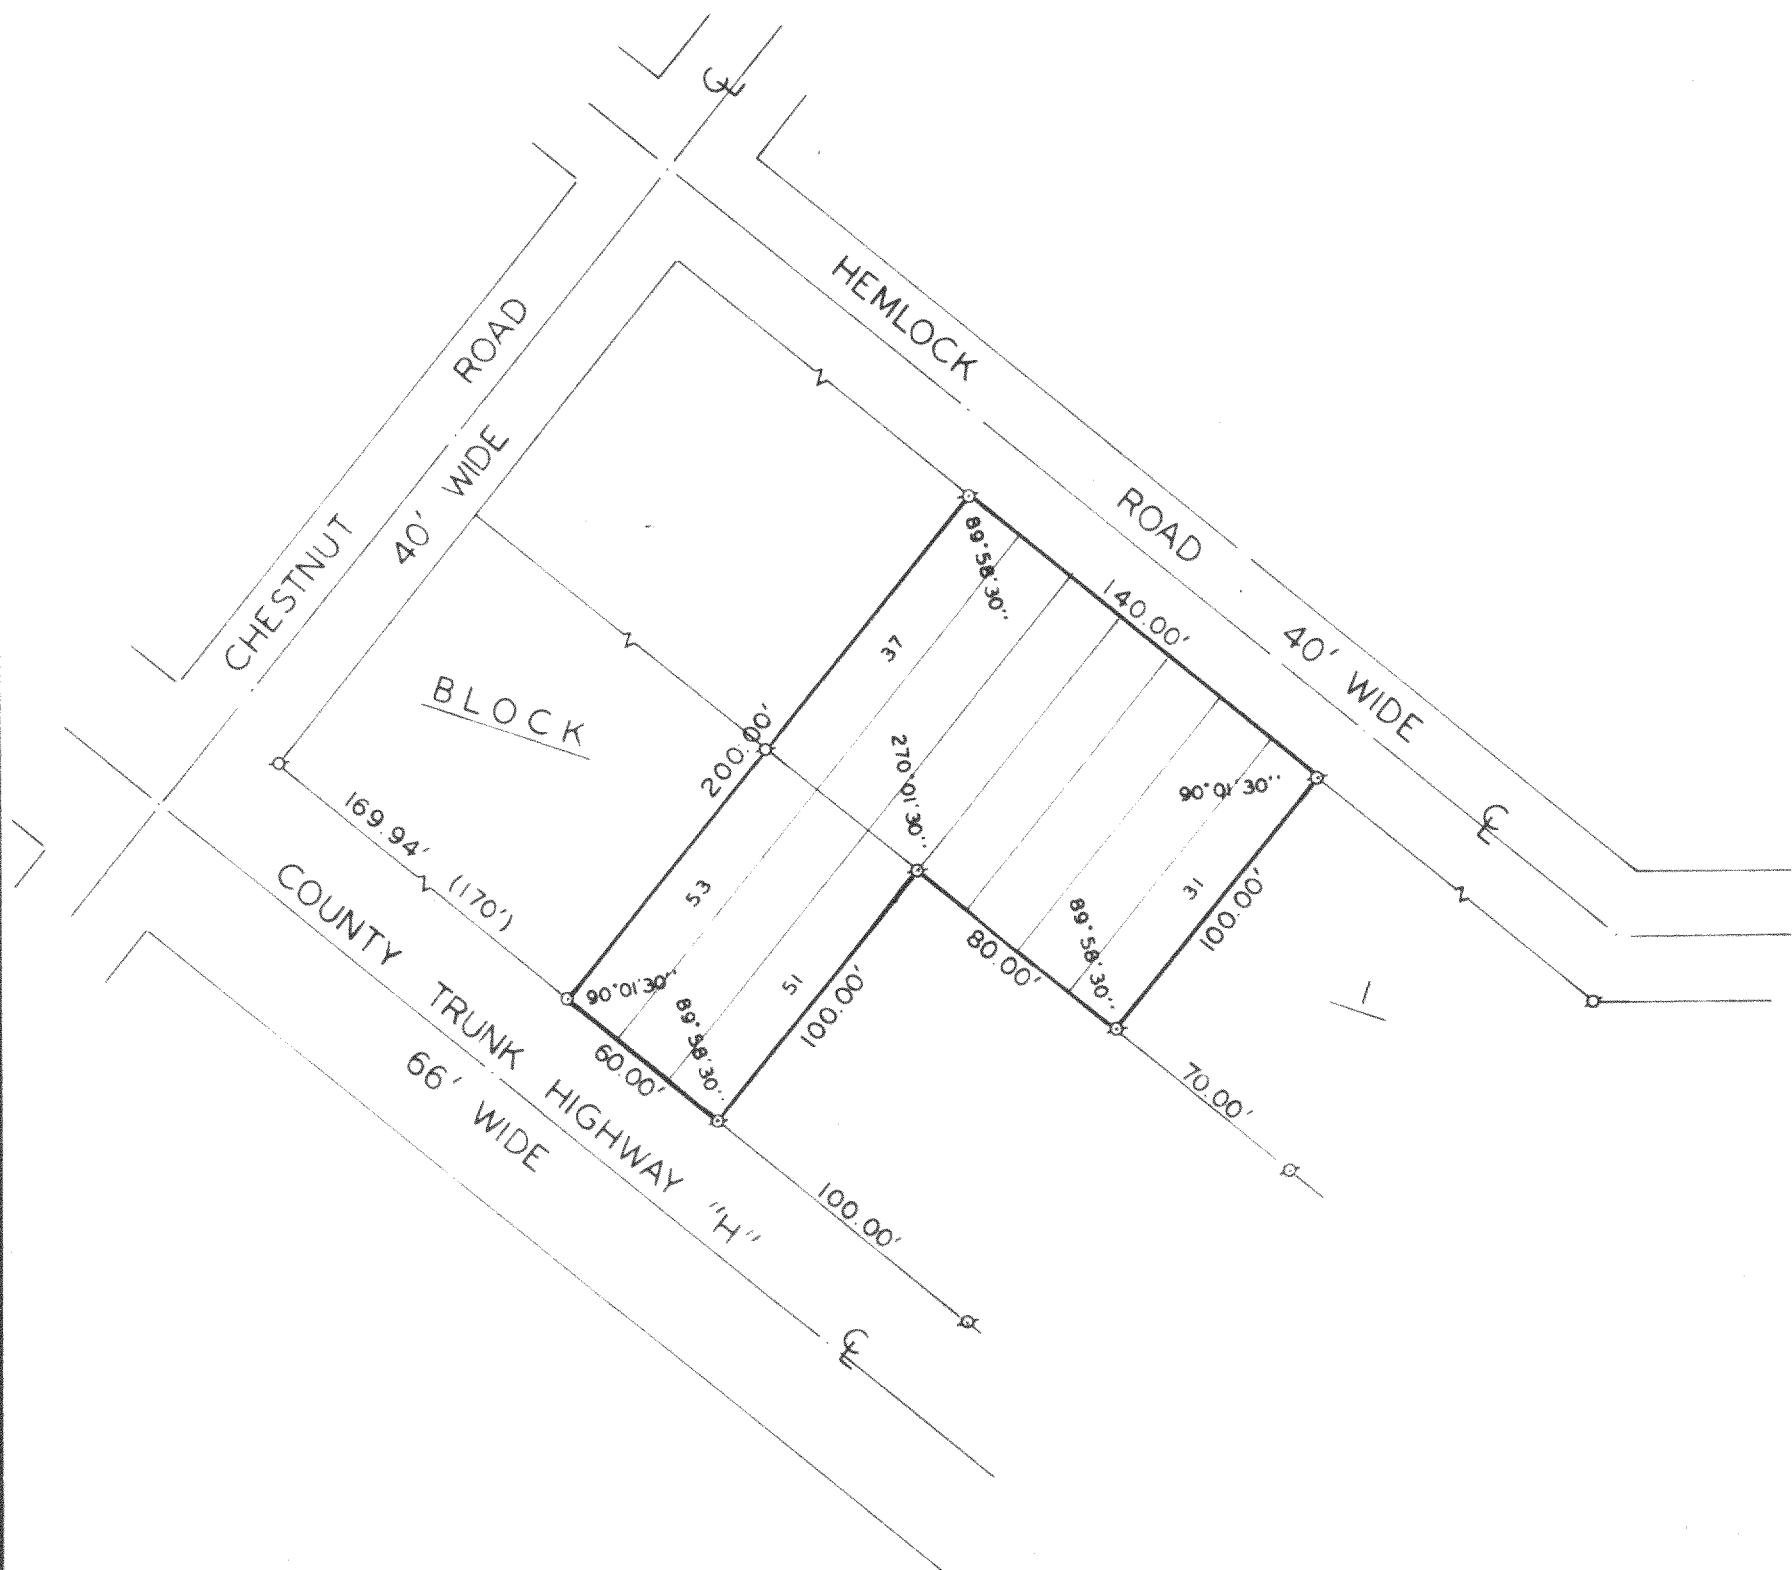

PLAT OF SURVEY OF

LOTS 31-37 AND LOTS 51-53, BLOCK 1,
 PELL LAKE SUBDIVISION, SECTION 1, T1N,
 R18E, WALWORTH COUNTY, WISCONSIN.

ORDERED BY: W. E. KINDER


ACCURACY: DISTANCES \pm 0.01'
 ANGLES \pm 05"
 ERROR OF CLOSURE--
 LESS THAN ONE PART IN 3000



SCALE: 1" = 60'

LEGEND

- φ - IRON PIPE FOUND
- - IRON PIPE PLACED
- - CONCRETE MONUMENT
- ✗ - SPIKE
- () - AS PLATTED

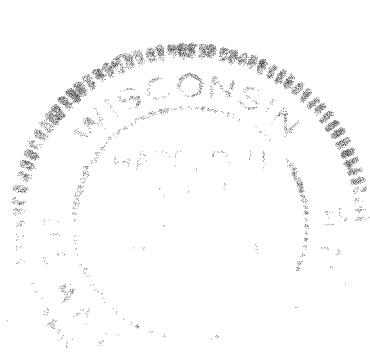

I, HAROLD H. KOLB, DO HEREBY CERTIFY THAT I HAVE SURVEYED THE PROPERTY HEREON DESCRIBED ACCORDING TO THE OFFICIAL RECORDS, AND THAT THE PLAT HEREON IS A CORRECT REPRESENTATION OF THE LOT LINES.

Harold H. Kolb

HAROLD H. KOLB
 WISCONSIN REGISTERED LAND SURVEYOR, S-187
 DATE Sept 23, 1976

118-545