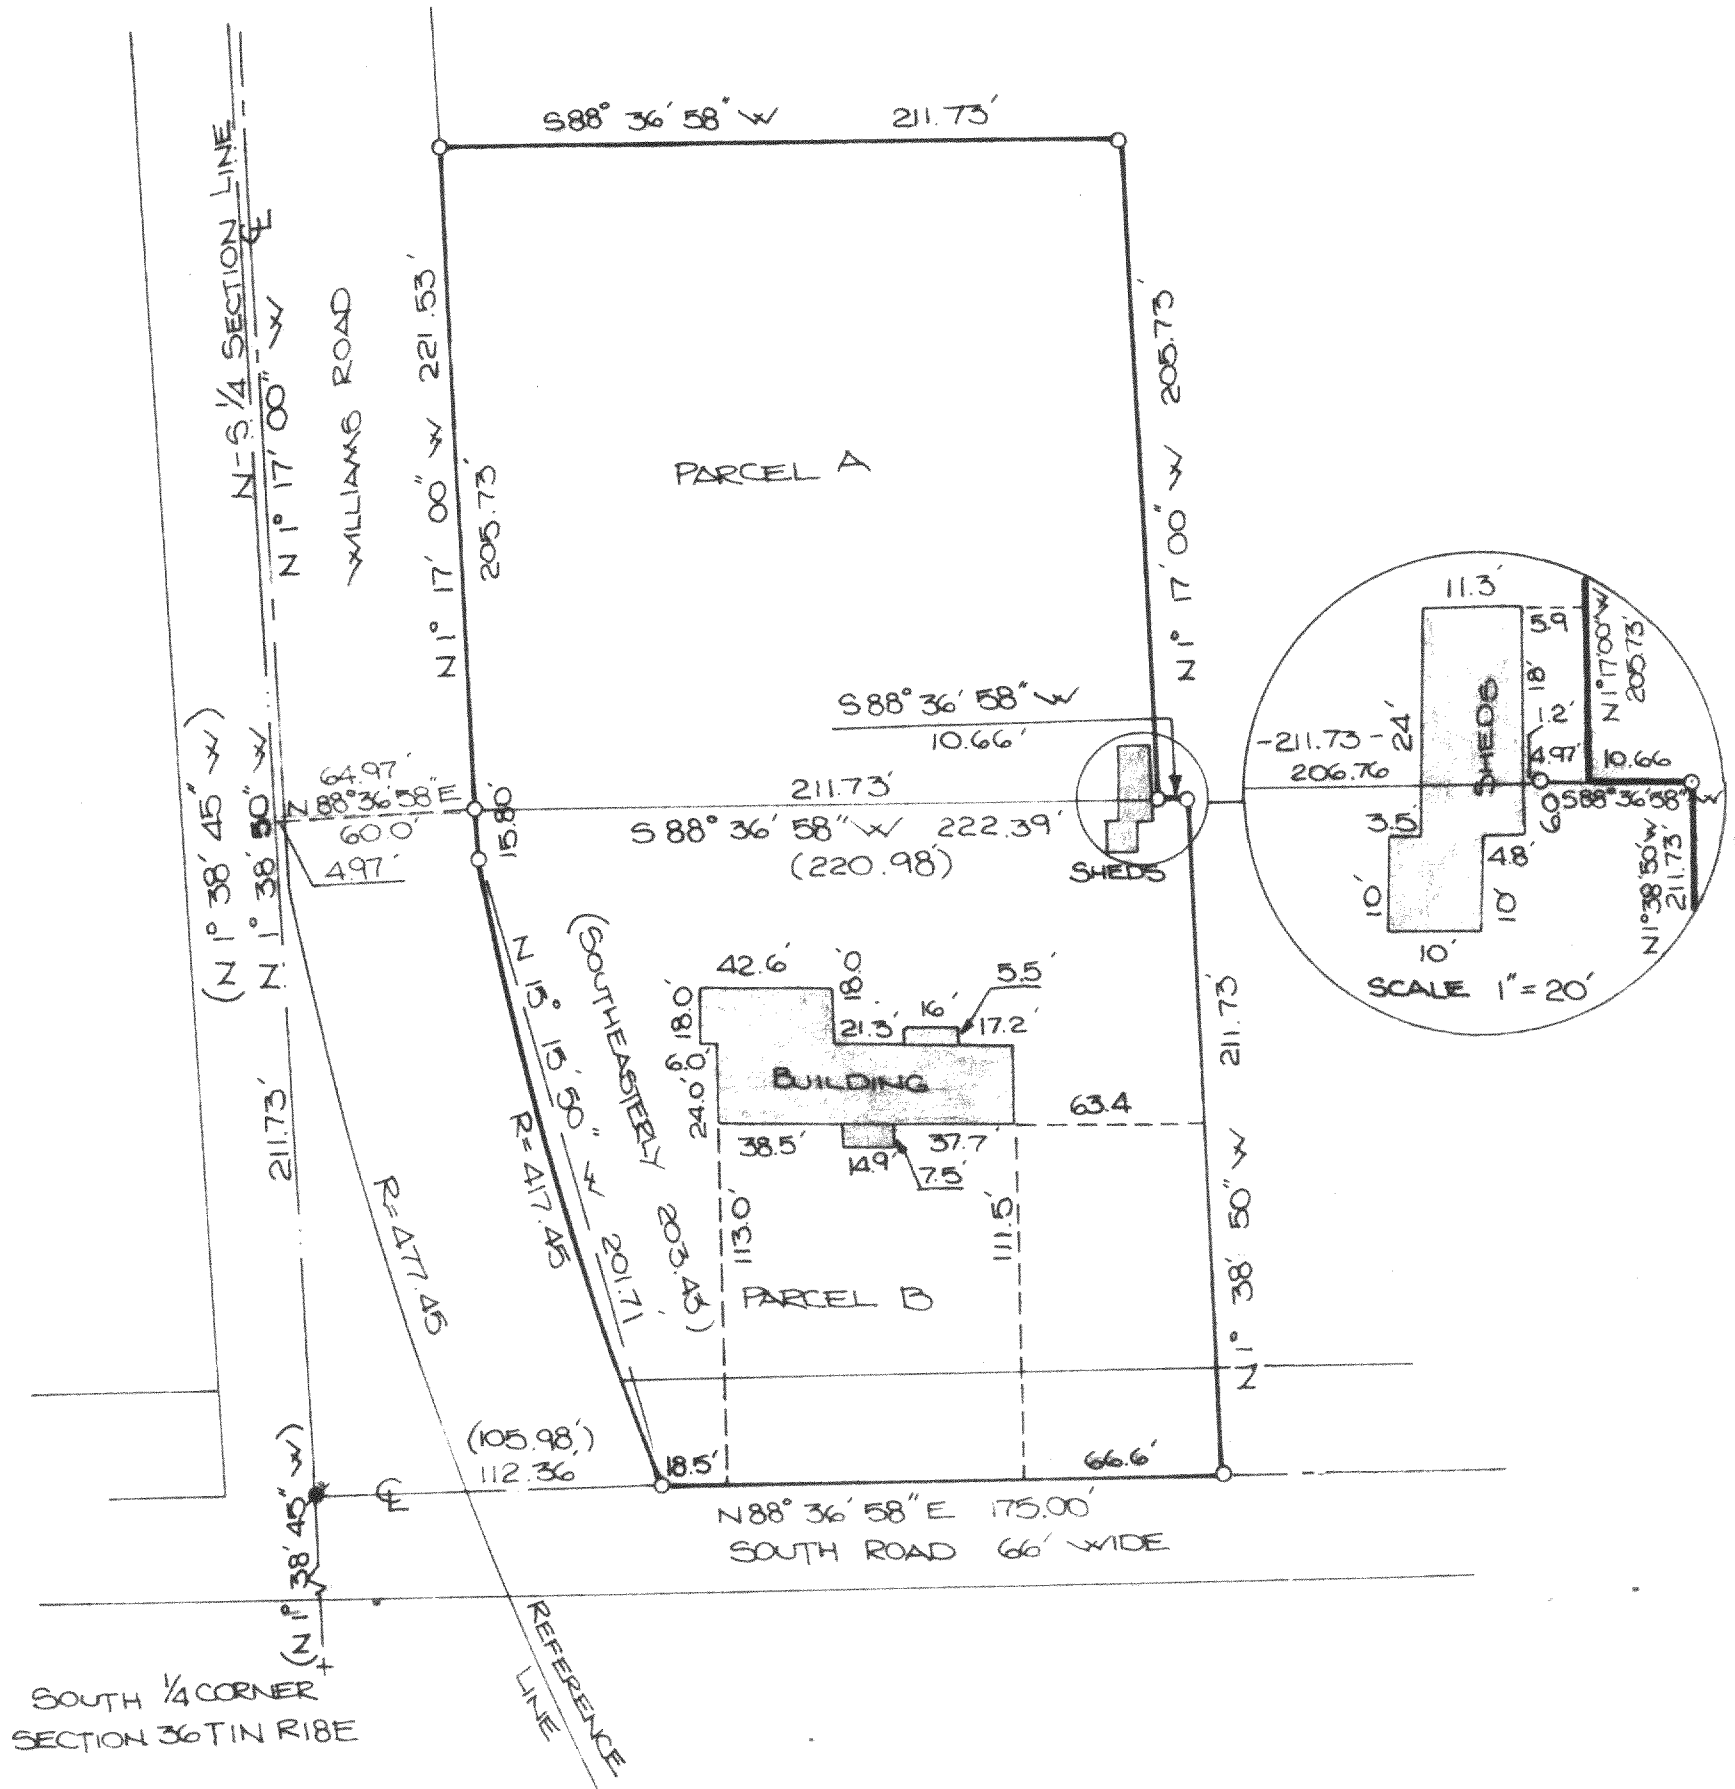


HAROLD H. KOLBREGISTERED PROFESSIONAL LAND SURVEYOR
LAKE GENEVA, WISCONSIN

PLAT OF SURVEY OF

PARCELS OF LAND LOCATED IN THE SOUTHEAST 1/4 OF
SECTION 36, T1N, R18E, WALWORTH COUNTY, WISCONSIN.


OWNER: LEO BLOOM

ACCURACY: DISTANCES $\pm 0.01'$
ANGLES $\pm 05''$
ERROR OF CLOSURE--LESS THAN
ONE PART IN 3000

N
↑
SCALE: 1"=60'

LEGEND

- φ - IRON PIPE FOUND
- - IRON PIPE PLACED
- ✕ - FERROUS MONUMENT FOUND
- x - SPIKE
- () - RECORDED AS

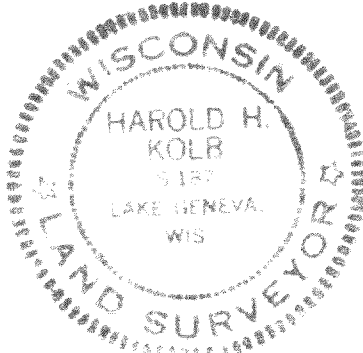

I, HAROLD H. KOLB, DO HEREBY CERTIFY THAT I HAVE
SURVEYED THE PROPERTY HEREON DESCRIBED ACCORDING
TO THE OFFICIAL RECORDS, AND THAT THE PLAT HEREON
IS A CORRECT REPRESENTATION OF THE LOT LINES.

Harold H. Kolb

HAROLD H. KOLB
WISCONSIN REGISTERED LAND SURVEYOR, S-187
DATE Aug 31, 1976

B-36-3C

118-556