


DUNHAM SURVEYING, S.C.
SURVEYING & SUBDIVIDING
DELAVER, WISCONSIN 53115

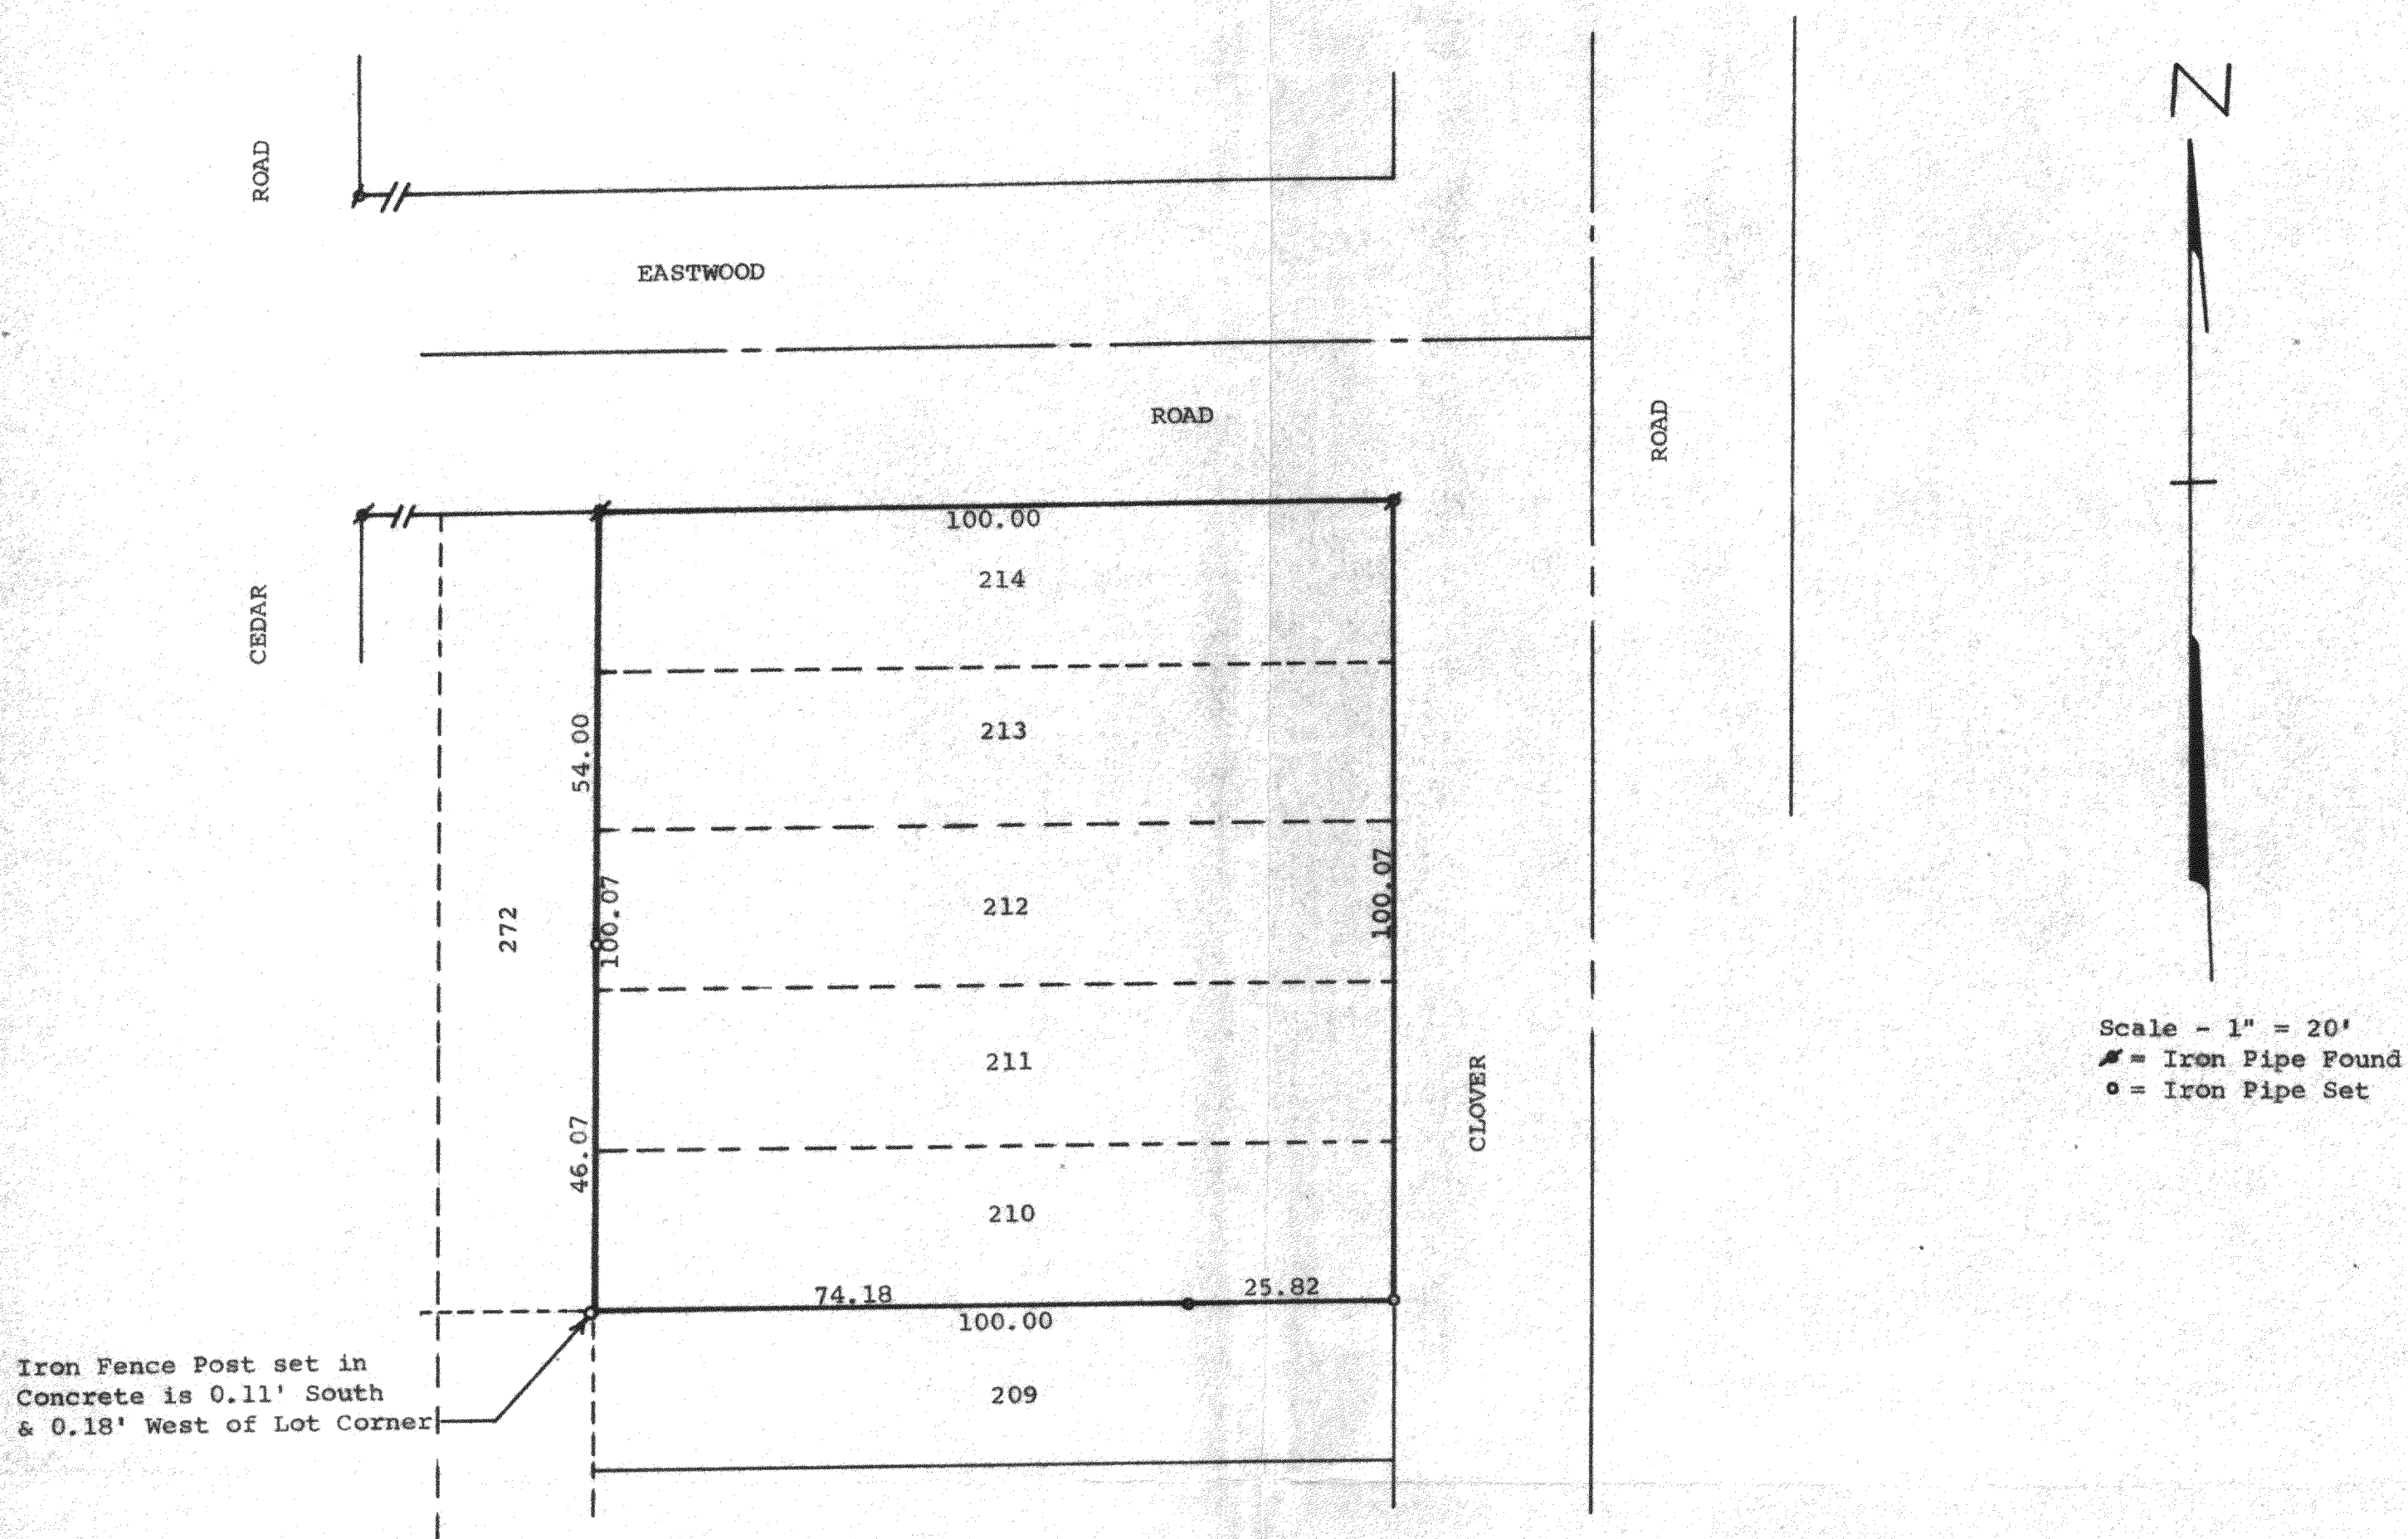

STATE OF WISCONSIN) SS
COUNTY OF WALWORTH)

I, George T. Dunham, Surveyor, certify that I have surveyed the property described as follows, Lots 210-214 inclusive, Pell Lake Highlands, located in Section 16, T1N, R18E, Walworth County, Wisconsin, and that the above map is a true representation thereof and shows the size and location of the property and any visible encroachments, if any.
April 15, 1977

George T. Dunham
George T. Dunham, Surveyor

