


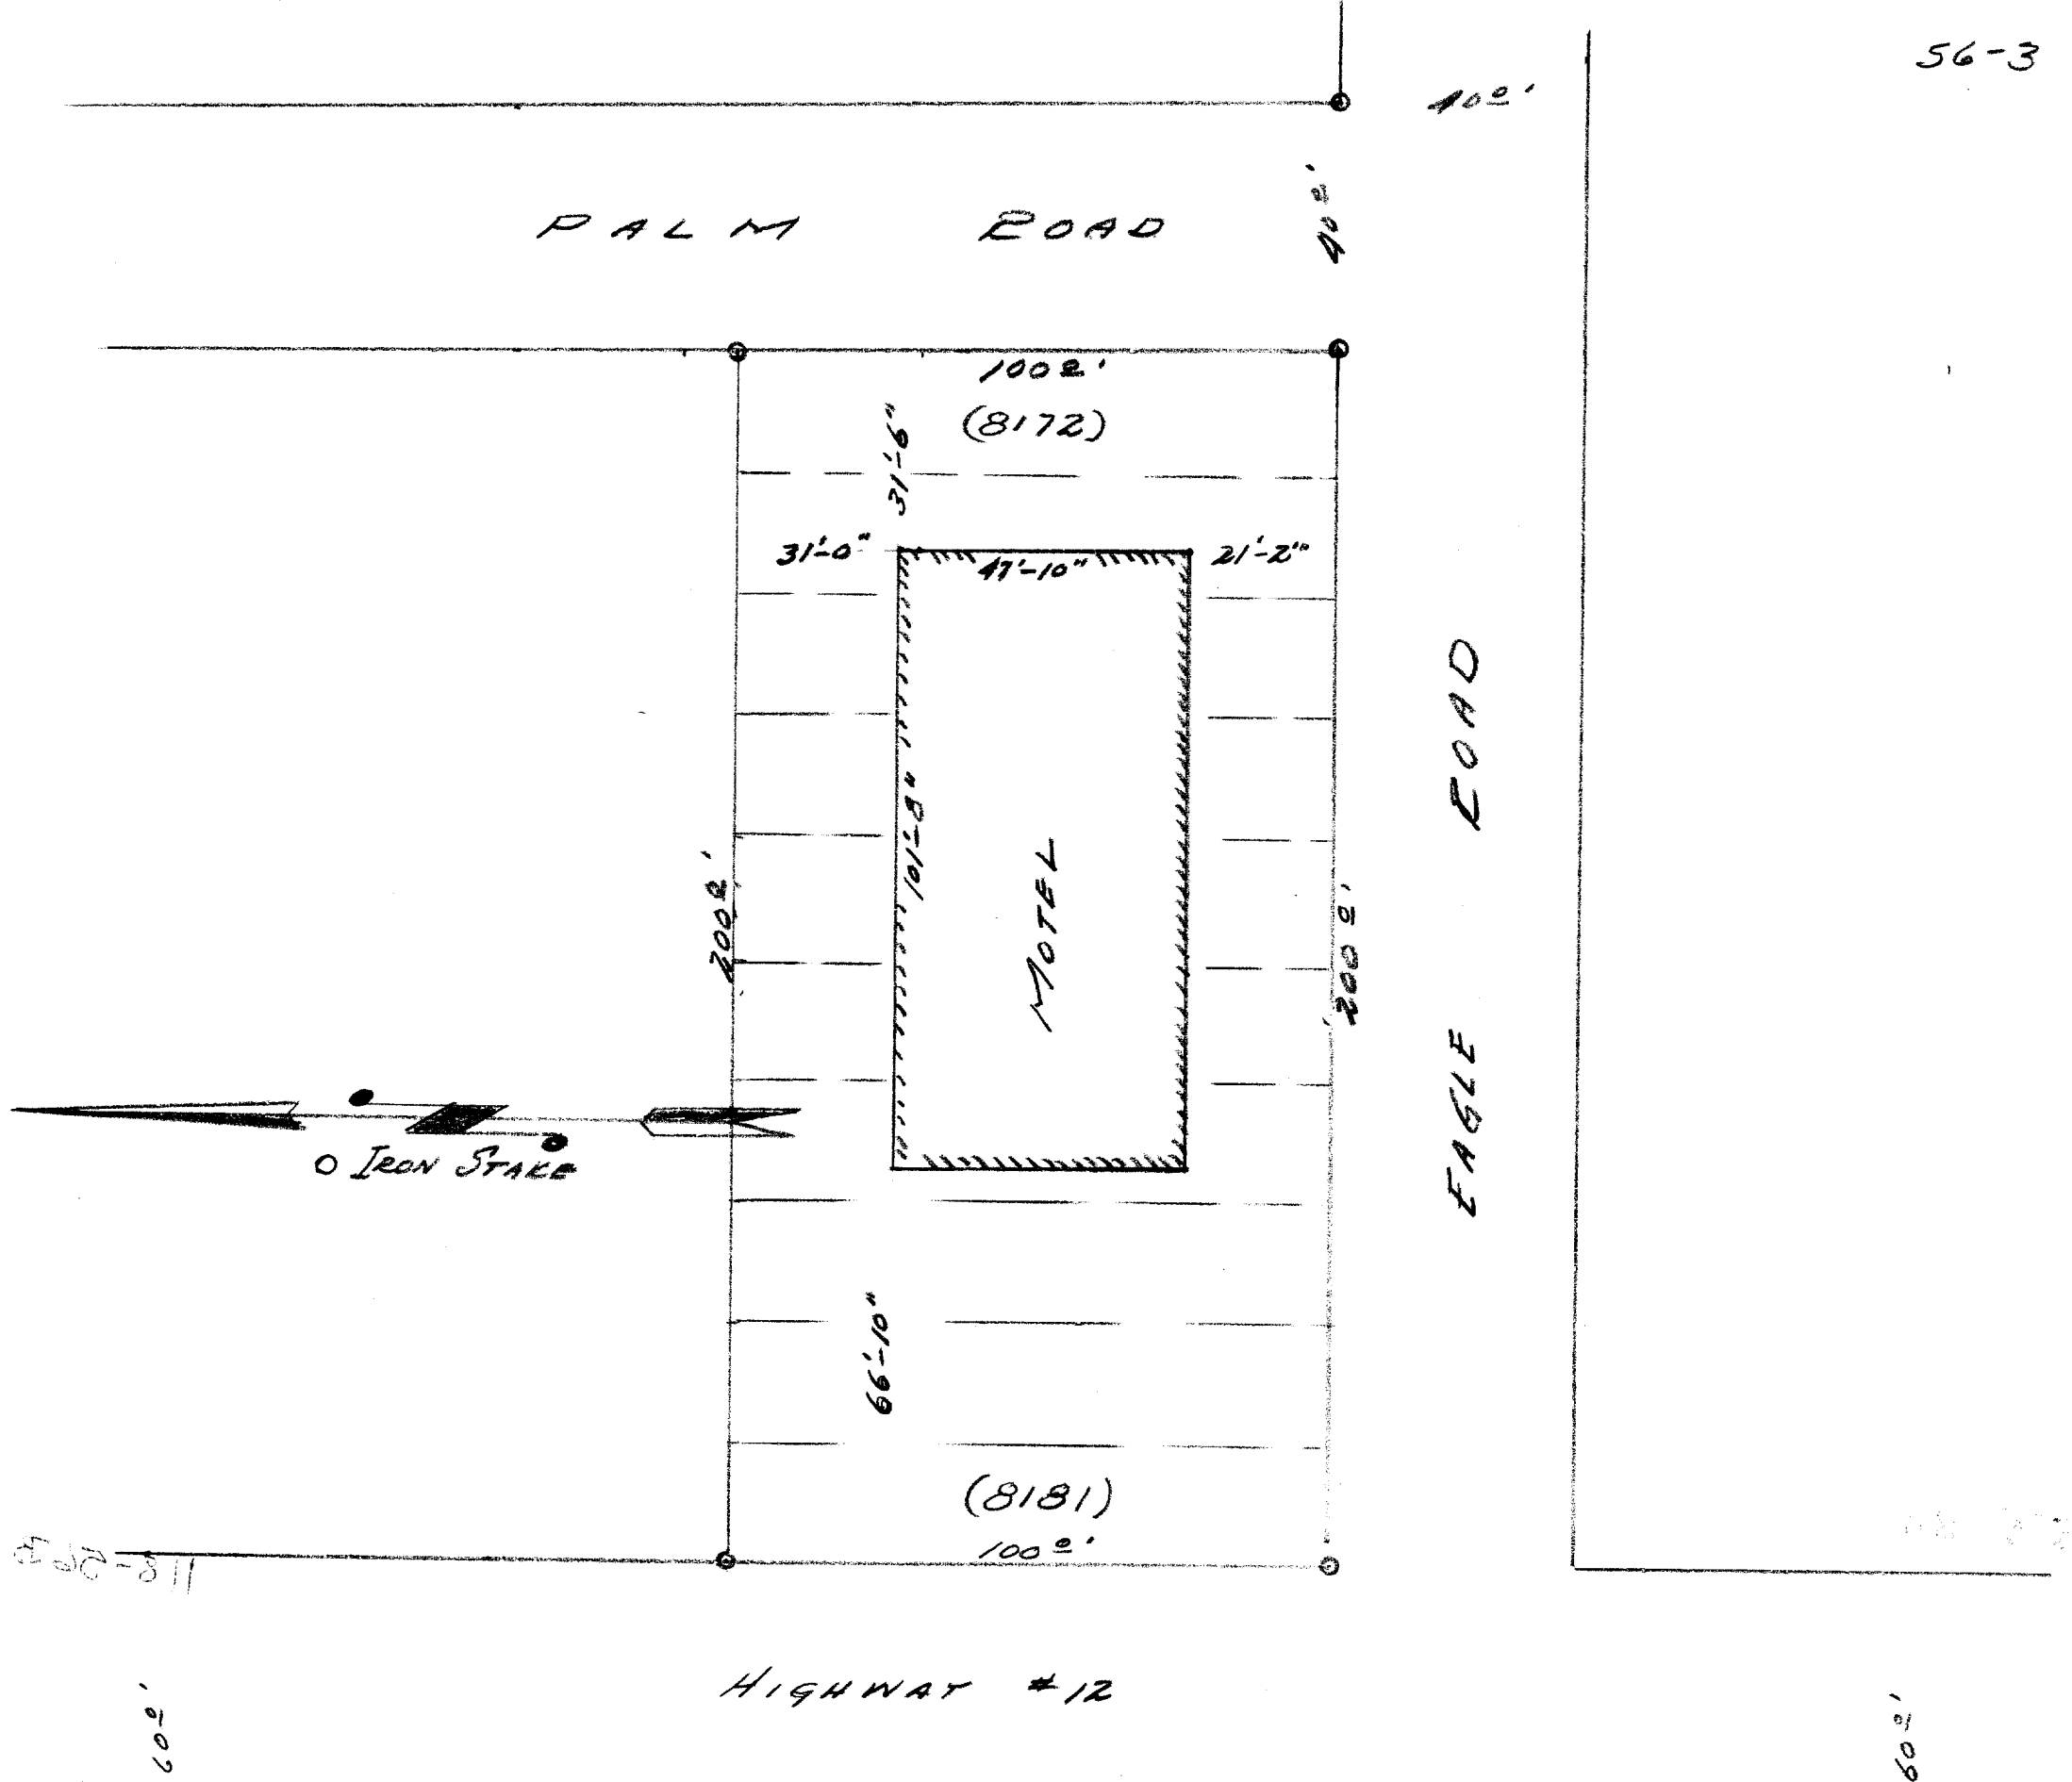

DESCRIPTION: Lots 8172, 8173, 8174, 8175, 8176, 8177, 8178, 8179, 8180, and 8181, as designated and delineated on the map entitled "Map of Section 5 of Pell Lake, Walworth County, Wisconsin and recorded in the office of the Register of Deeds in and for Walworth County and State of Wisconsin on the 2nd day of September 1924.

CERTIFICATE: I, hereby certify that I have on this the 17th day of April 1956, surveyed the above described property according to the official record on file in the office of the Recorder of Deeds in and for Walworth County, Wisconsin, and find that the measurements and bearings of the boundary lines of said property as taken at the site on this day, substantially agree with those stated in said official record, and that the building presently constructed upon said property is wholly within the boundaries of said property and is located as portrayed on the plat here shown, and that no encroachments exist. SIGNED AND SEALED ON THIS THE 18TH DAY OF APRIL 1956.

Joseph M. Biagi
 JOSEPH M. BIAGI, Professional Engineer
 and
 Land Surveyor.
 Elkhorn Wisconsin.