


DUNHAM & RASMUSSEN
SURVEYING & ENGINEERING
DELAVER, WISCONSIN

N
SCALE: 1"=20'
IRON PIPE

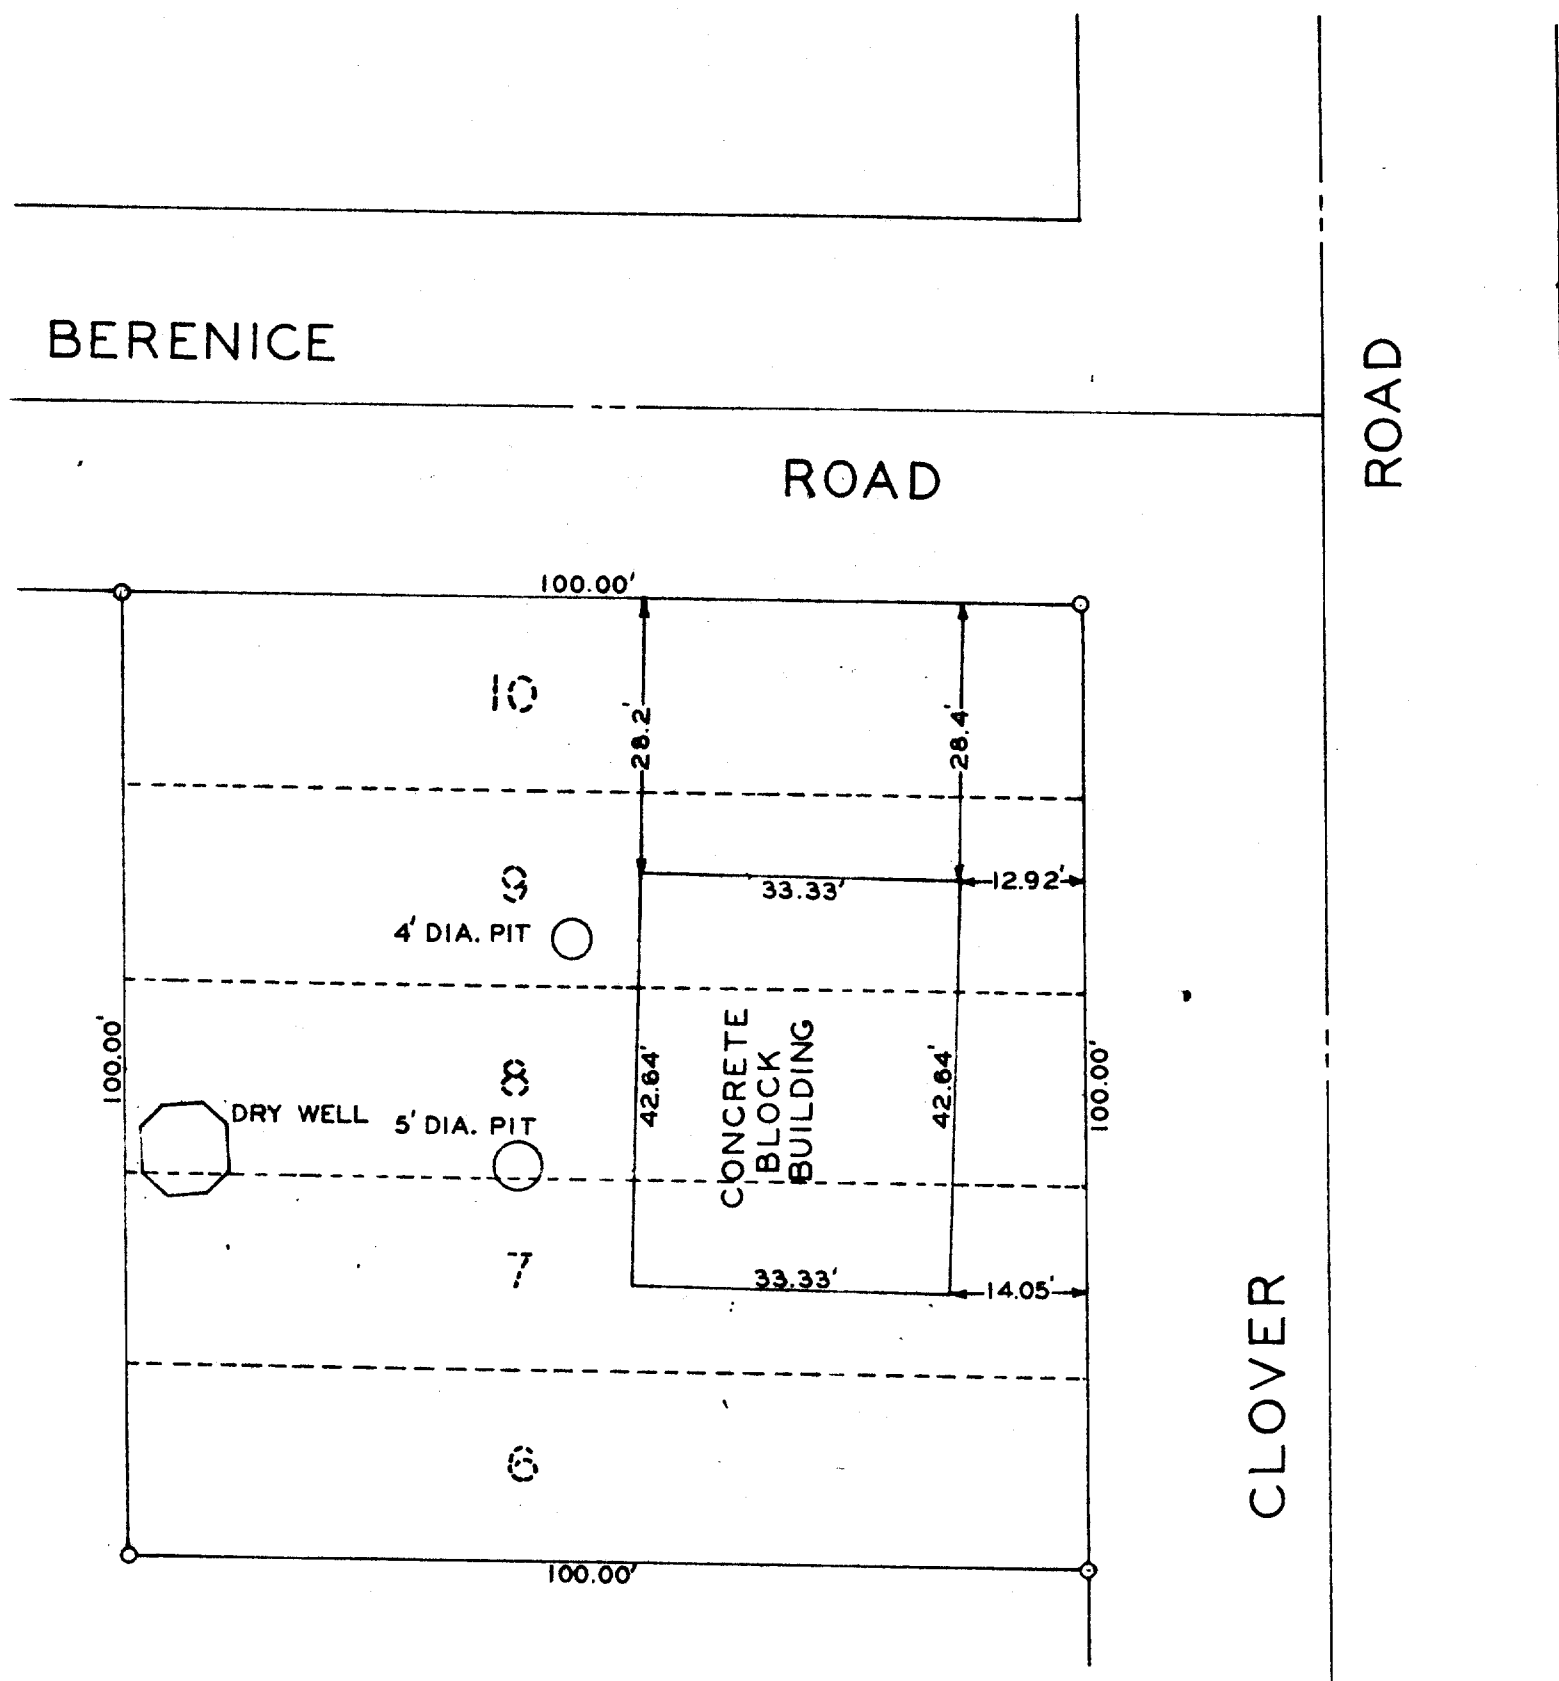

STATE OF WISCONSIN)
WALWORTH COUNTY,)SS

I George T. Dunham, do hereby certify that I have surveyed the property described as follows,

Lots 6-10 inclusive of Block 1 of Pell Lake Highlands located in Section 16, T 1 N R 18 E of Walworth County, Wisconsin and that the plat shown above is a correct representation of the property lines and of the improvements located thereon
March 21, 1961

George T. Dunham
George T. Dunham, Wis. Land Surveyor No. S-306