

ETC-811

H YACINTH

ROAD

JUNEAU


ROAD

ETC-811

100.2'		100.2'	
202'	3912	202'	3855
"	"	"	"
"	3911	"	3856
"	"	"	"
"	3910	"	3857
100.2'			
202'	3909	202'	3858
"	"	"	"
"	3908	"	3859
"	"	"	"
"	3907	"	3860
"	"	"	"
202'	3906	202'	3861
100.2'			
"	3905	"	3862
"	"	"	"
"	3904	"	3863
"	"	"	"
"	3903	"	3864
"	"	"	"
"	3902	"	3865
"	"	"	"
"	3901	"	3866
"	"	"	"
"	3900	"	3867
"	"	"	"
"	3899	"	3868
"	"	"	"
"	3898	"	3869
"	"	"	"
"	3897	"	3870
"	"	"	"
"	3896	"	3871
"	"	"	"
"	3895	"	3872
"	"	"	"
"	3894	"	3873
"	"	"	"
"	3893	"	3874
"	"	"	"
"	3892	"	3875
"	"	"	"
"	3891	"	3876
"	"	"	"
"	3890	"	3877
"	"	"	"
202'	3889	202'	3878
100.2'		100.2'	
202'	"	202'	"
"	"	"	"
"	"	"	"
"	"	"	"
202'	3888	202'	3882
"	"	"	"
"	3887	"	3881
"	"	"	"
"	3886	"	3880
"	"	"	"
"	3885	"	"
"	"	"	"
"	3884	"	"
100.2'		100.2'	
202'	"	202'	"
"	"	"	"
"	"	"	"
"	"	"	"
202'	3883	202'	3879
"	"	"	"
"	"	"	"
"	"	"	"
"	"	"	"
202'	"	202'	"

(Easement of outbuilding encroachment on lots 3858 & 3859 by 9 inches)

JASMINE DRIVE

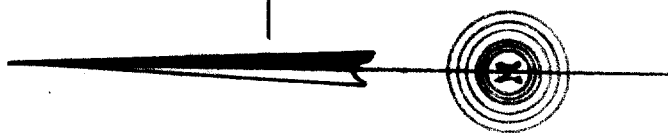

DESCRIPTION: Lots 3906, 3907, 3908, and 3909; as designated and delineated on the map entitled "Map of Section Three of Pell Lake, Walworth County, Wisconsin".

CERTIFICATE: I, hereby certify that I have on this the 18th day of September, 1954, surveyed the above described property, according to the official record on file in the office of the Recorder of Deeds in and for Walworth County Wisconsin, and find that the measurements and bearings of the boundary lines of said property as taken at the site on this day, substantially agree with those on said official plat, and that an out building situated on portions of lots 3908 and 3909 encroaches by nine inches upon lots 3858 and 3859.

SIGNED AND SEALED ON THIS THE 20TH DAY OF SEPTEMBER 1954.

118-57B

Joseph M. Biagi, Professional Engineer, Wisconsin