


HAROLD H. KOLB

REGISTERED PROFESSIONAL LAND SURVEYOR
LAKE GENEVA, WISCONSIN

CHICAGO ROAD 40' WIDE

40' WIDE

JUNEAU ROAD

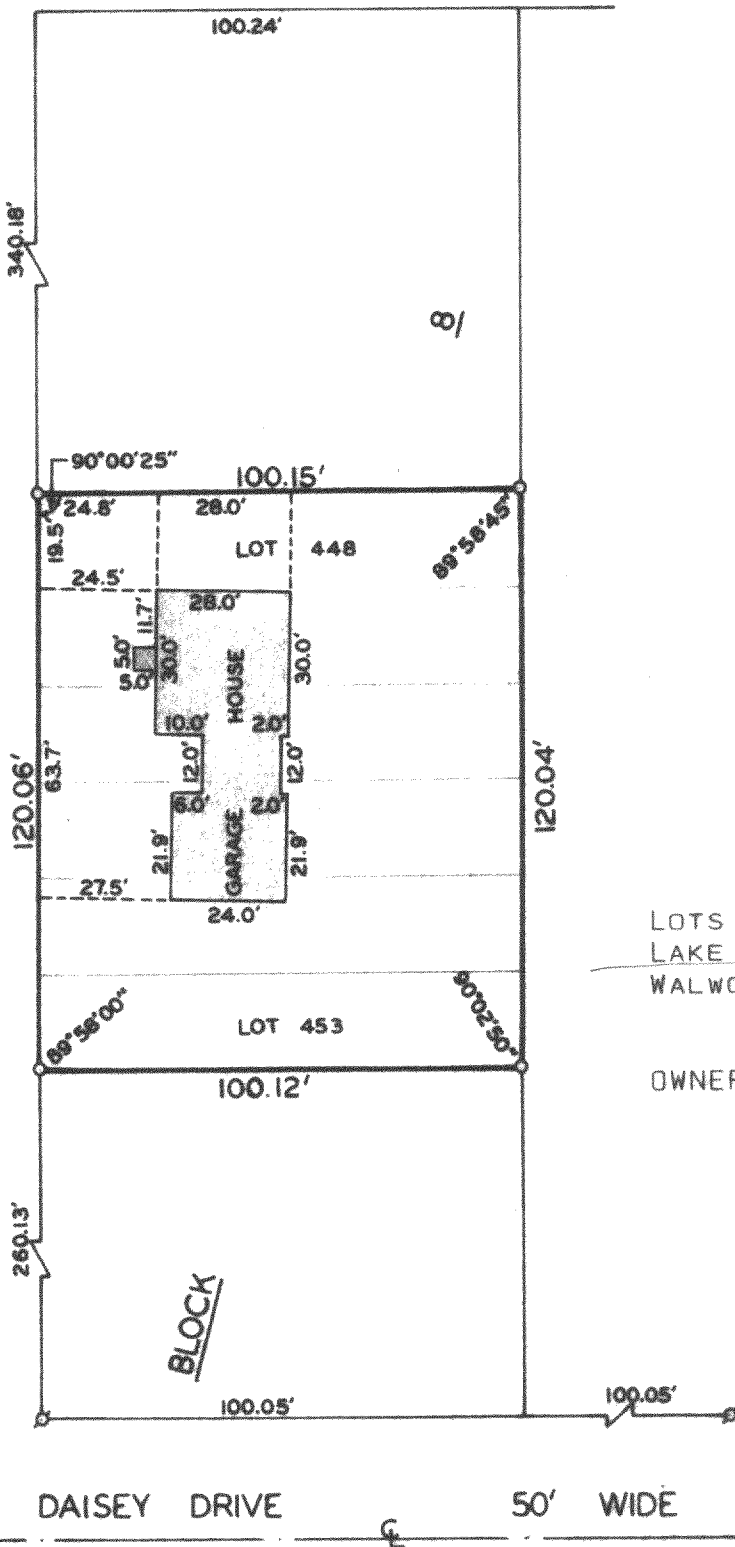

PLAT OF SURVEY OF

LOTS 448-453, BLOCK 8, PELL
LAKE ADDITION, T 1 N, R 18 E,
WALWORTH COUNTY, WISCONSIN.

OWNER: STEFAN ORZEL



I, HAROLD H. KOLB, DO HEREBY CERTIFY THAT I HAVE
SURVEYED THE PROPERTY HEREON DESCRIBED ACCORDING
TO THE OFFICIAL RECORDS, AND THAT THE PLAT HEREON
IS A CORRECT REPRESENTATION OF THE LOT LINES.

Harold H. Kolb

HAROLD H. KOLB
WISCONSIN REGISTERED LAND SURVEYOR, S-187

DATE *Aug. 18, 1977*

SCALE: 1" = 40'
LEGEND

- — IRON PIPE PLACED. 1" x 24" 1.13 LB./LIN. FT.
- — CONCRETE MONUMENT. 5" DIA. x 30"

118-581