


KOLB LAND CONSULTING, INC.
LAND SURVEYING • SUBDIVIDING • LAND PLANNING

LAKE GENEVA, WISCONSIN 53147


WHITEWATER, WISCONSIN 53190

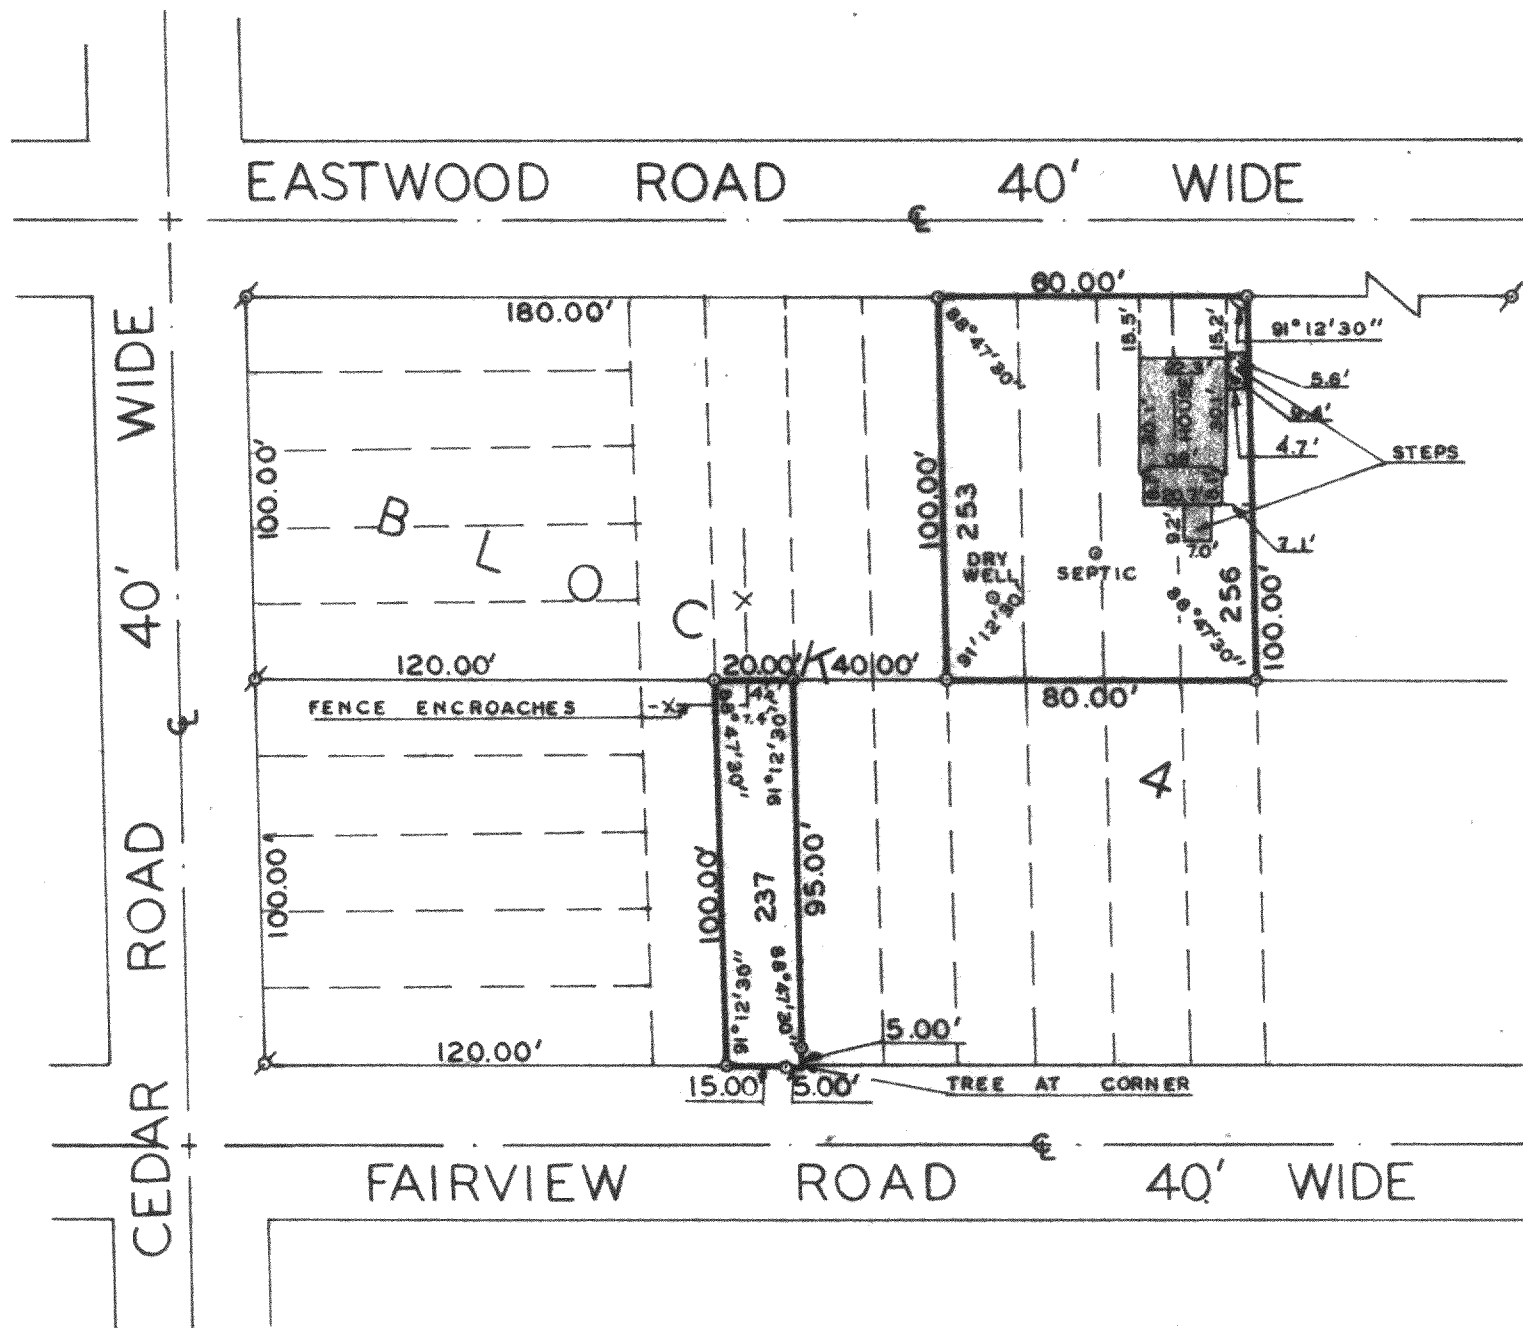

PLAT OF SURVEY OF

LOT 237, AND 253-256, BLOCK 4,
PELL LAKE HIGHLANDS, WALWORTH
COUNTY, WISCONSIN.


ORDERED BY: JAN SPENCER
BAY REALTY
9 GENEVA STREET
WILLIAMS BAY, WI 53191

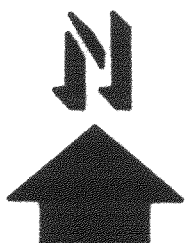

0 20 40
10 30 50

SCALE IN FEET
LEGEND

♂ - IRON PIPE FOUND
o - IRON PIPE PLACED

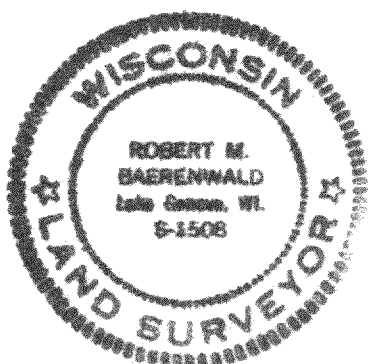

I, ROBERT M. BAERENWALD, DO HEREBY CERTIFY THAT I
HAVE SURVEYED THE PROPERTY HEREON DESCRIBED ACCORD-
ING TO THE OFFICIAL RECORDS, AND THAT THE PLAT
HEREON IS A CORRECT REPRESENTATION OF THE LOT LINES
TO THE BEST OF MY KNOWLEDGE AND BELIEF.

ROBERT M. BAERENWALD
WISCONSIN REGISTERED LAND SURVEYOR, S-1508

DATE

July 17, 1979

118-583K