

NORTHEASTERLY LINE OF LOT
ASSUMED TO BEAR N 33° 12' W AS
PREVIOUSLY PLATTED

UNIMPROVED ROAD
JOY DRIVE
50' WIDE

LOT 4

LOT 5

LOT 6

SURVEY ORDERED BY
RANDALL LEECE ATTY.
ELKHORN WIS.

● FOUND 1 1/4" O.D. IRON PIPE
(XX) RECORDED DIST. & BEARINGS
XXX MEASURED DIST. & BEARINGS



SCALE 1" = 30'


PLAT OF SURVEY OF LOT 5 OF
LAKE TOMBEAU WOODS, A SUBDIVISION
LOCATED IN THE NW 1/4 OF THE SE 1/4 OF
SECTION 24, TOWN 1 NORTH, RANGE 18 EAST,
WALWORTH COUNTY, WISCONSIN.

THE ABOVE-DESCRIBED PROPERTY HAS BEEN
SURVEYED UNDER MY DIRECTION AND THE ABOVE MAP
IS A TRUE REPRESENTATION THEREOF AND SHOWS
THE SIZE & LOCATION OF THE PROPERTY TO THE
BEST OF MY KNOWLEDGE AND BELIEF

Robert A. Farris

ROBERT A. FARRIS, SURV.

DATED THIS 22nd DAY OF March 1978

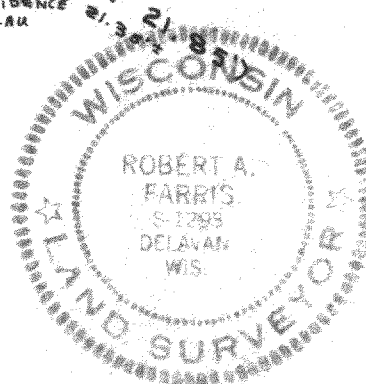

715 W. WALWORTH AVE., P.O. BOX 467
ELKHORN, WISCONSIN 53121
TELEPHONE 414-723-2096

DRAWING NO. 1320

MLTW-5