


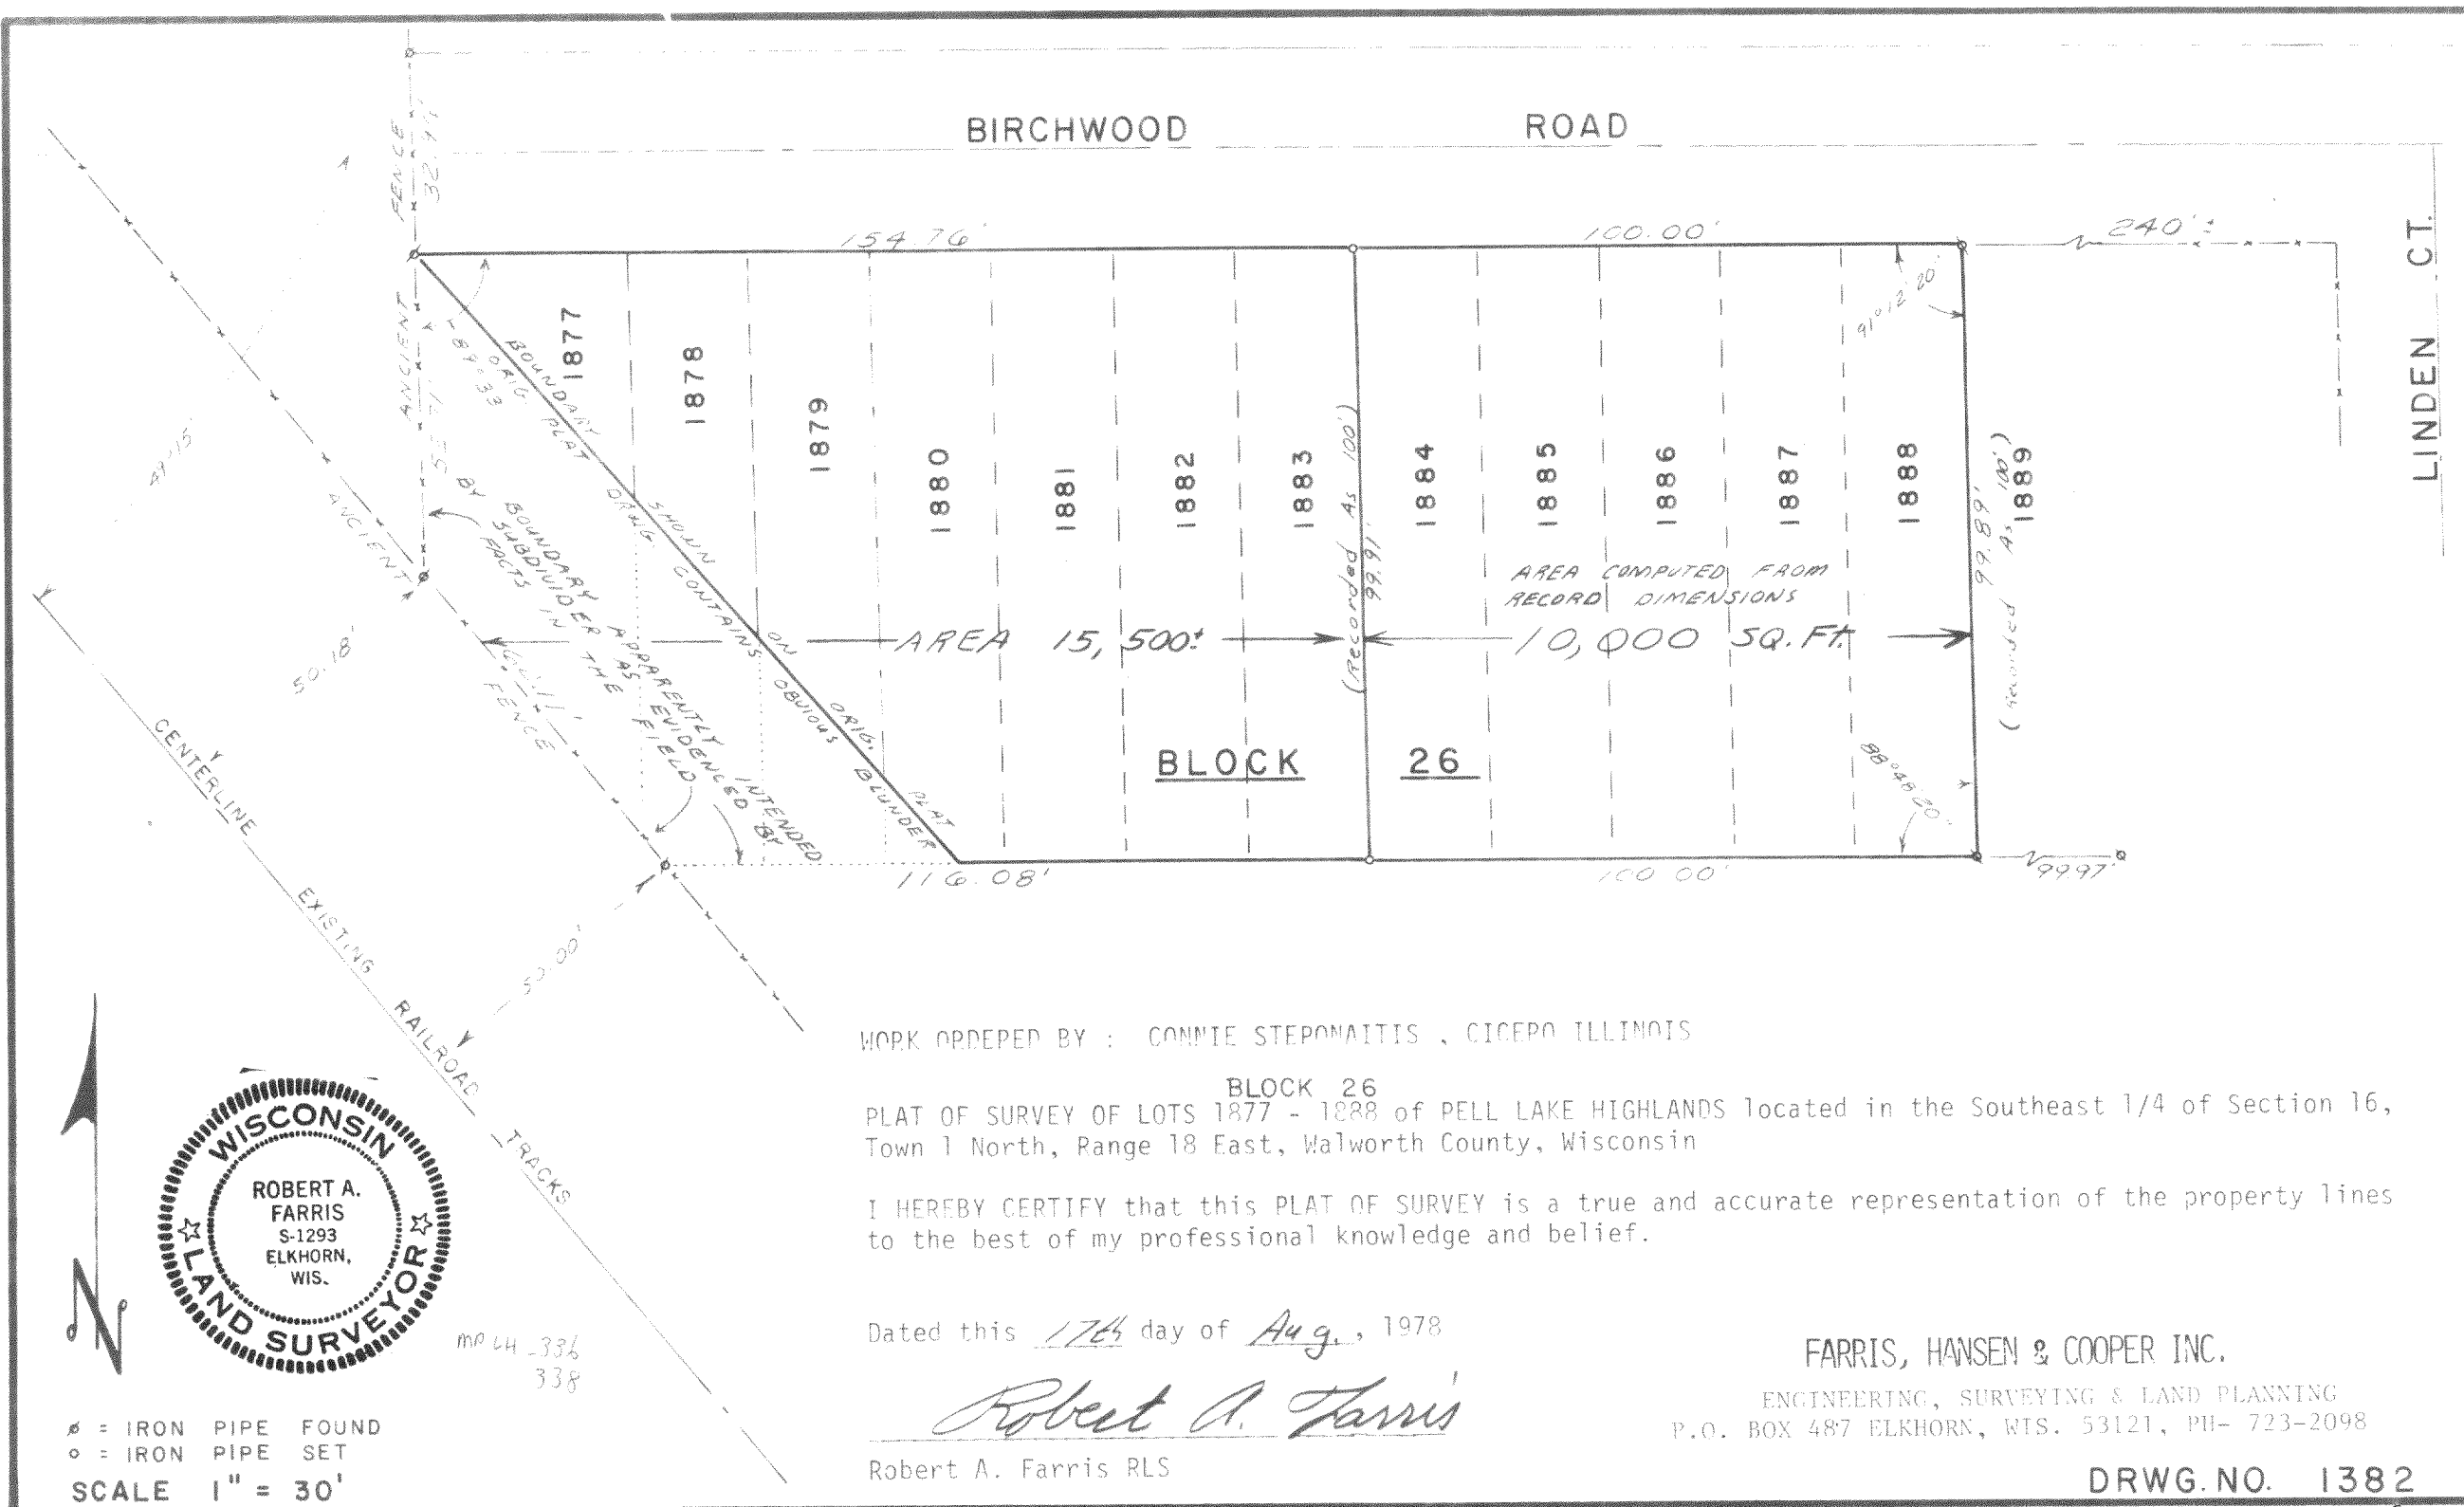

WORK ORDERED BY : CONNIE STEPONAITIS , CICEPO ILLINOIS

BLOCK 26
PLAT OF SURVEY OF LOTS 1877 - 1888 of PELL LAKE HIGHLANDS located in the Southeast 1/4 of Section 16, Town 1 North, Range 18 East, Walworth County, Wisconsin

I HEREBY CERTIFY that this PLAT OF SURVEY is a true and accurate representation of the property lines to the best of my professional knowledge and belief.

Dated this 17th day of Aug., 1978

Robert A. Farris
Robert A. Farris RLS

FARRIS, HANSEN & COOPER INC.
ENGINEERING, SURVEYING & LAND PLANNING
P.O. BOX 487 ELKHORN, WIS. 53121, PH- 723-2098