


HOME OFFICE  
109 SOUTH SPRING STREET  
BURLINGTON, WISCONSIN 53108  
PHONE: 414-763-2652  
414-763-7834

**ROBERS & BOYD, INC.**  
CONSULTING ENGINEERS  
LAND SURVEYORS

BRANCH OFFICE  
809 - 43RD STREET  
KENOSHA, WISCONSIN 53140  
PHONE: 414-658-4488


PLAT OF SURVEY & HOUSE LOCATION  
for  
POWERS LAKE REALTY

of  
Lot 5, Nippersink Highlands, a subdivision located in the NE  $\frac{1}{4}$  of the  
NE  $\frac{1}{4}$  and the NW  $\frac{1}{4}$  of the NE  $\frac{1}{4}$  of Section 24, being Government Lot 1  
of Section 24, T 1 N., R 18E, Township of Bloomfield, Walworth County,  
Wisconsin.

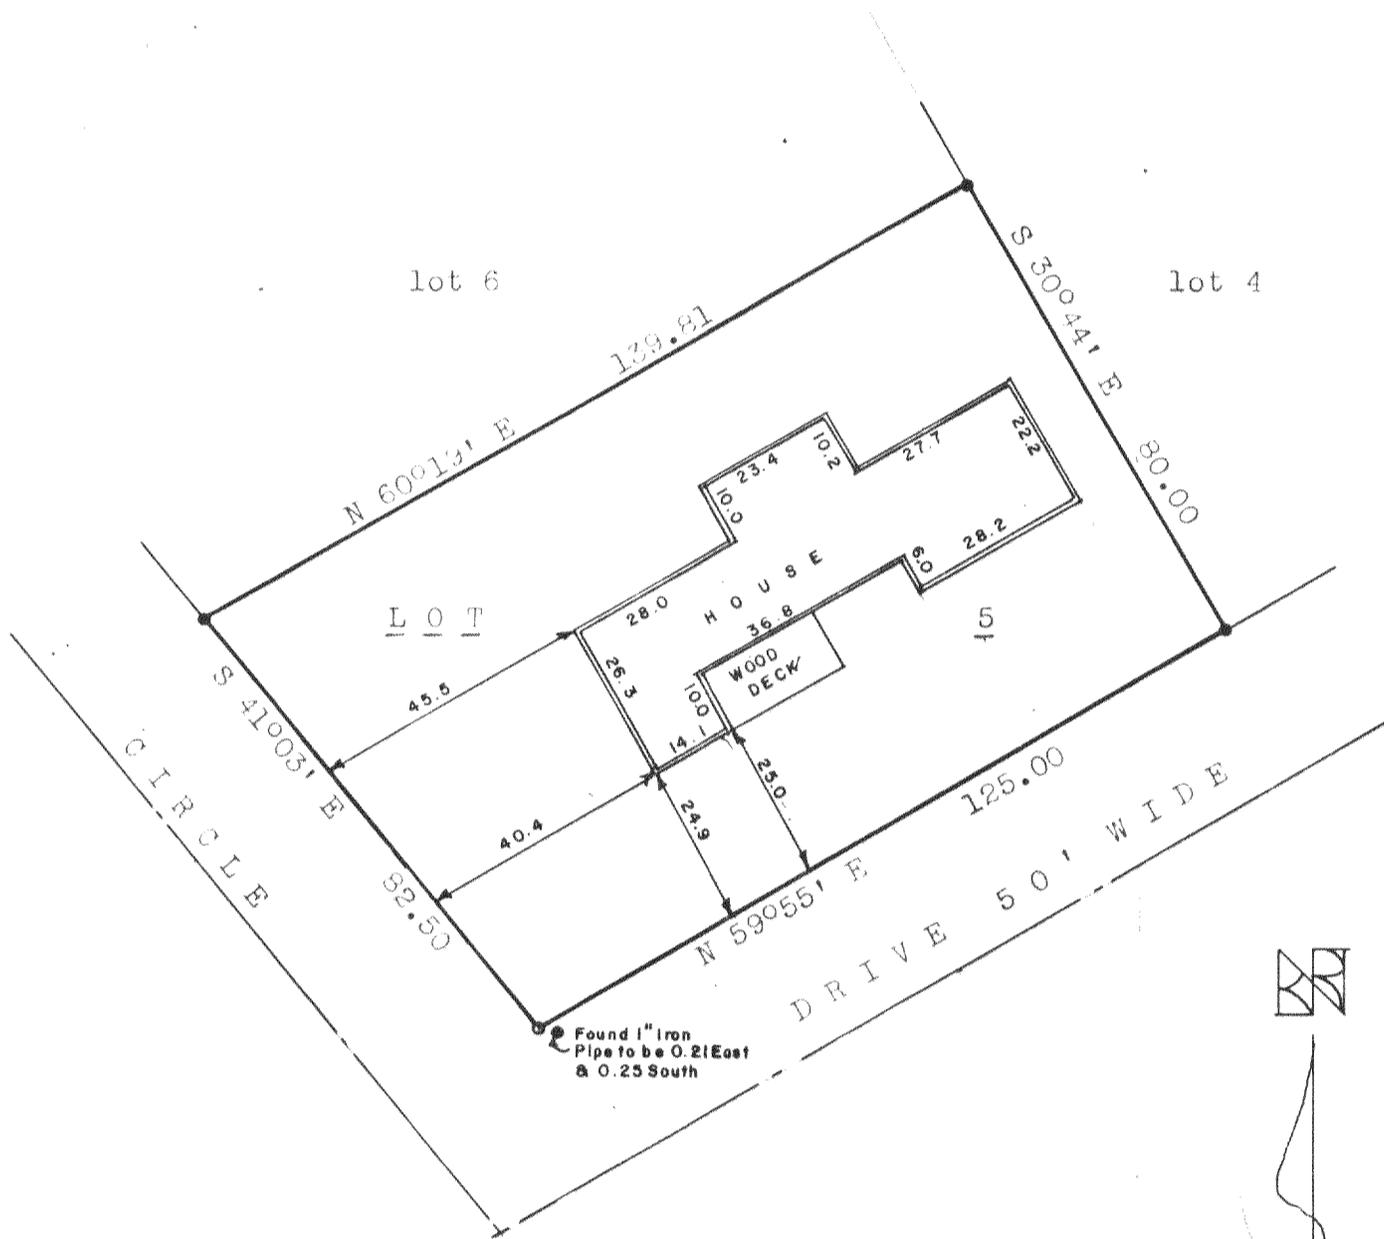

\* LEGEND \*

- Found 1" I.D. Iron Pipe
  - Set 1" O.D. Iron Pipe
- SCALE 1" = 30'

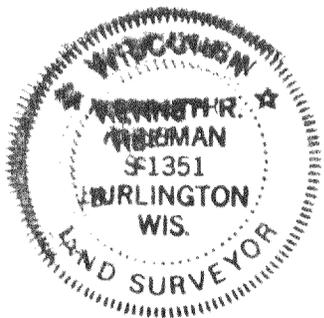

"I CERTIFY THAT I HAVE SURVEYED THE ABOVE DESCRIBED  
PROPERTY AND THAT THE ABOVE PLAT IS AN ACCURATE  
SURVEY AND A TRUE REPRESENTATION THEREOF AND COR-  
RECTLY SHOWS THE EXTERIOR BOUNDARY LINES AND LOCA-  
TION OF BUILDINGS ON SAID PROPERTY AND THE CORRECT  
MEASUREMENTS THEREON"

*Kenneth R. Wiseman*  
WISCONSIN REGISTERED LAND SURVEYOR

8-22-79  
DATE

79169 A  
JOB NUMBER