

PLAT OF SURVEY
OF



LOT 9, BLOCK 4, ROSE NIPPERSINK GARDENS, A SUBDIVISION LOCATED IN SECTION 24, T. 1 N., R. 18 E. OF THE 4TH P.M.,
TOWNSHIP OF BLOOMFIELD, COUNTY OF WALMOTH, STATE OF WISCONSIN.

FOR: FRANK STUMPF.

SCALE 1" = 40'

○ = IRON PIPE STAKE ● = CONCRETE MONUMENT

BEARINGS ARE THOSE OF RECORDED PLAT.

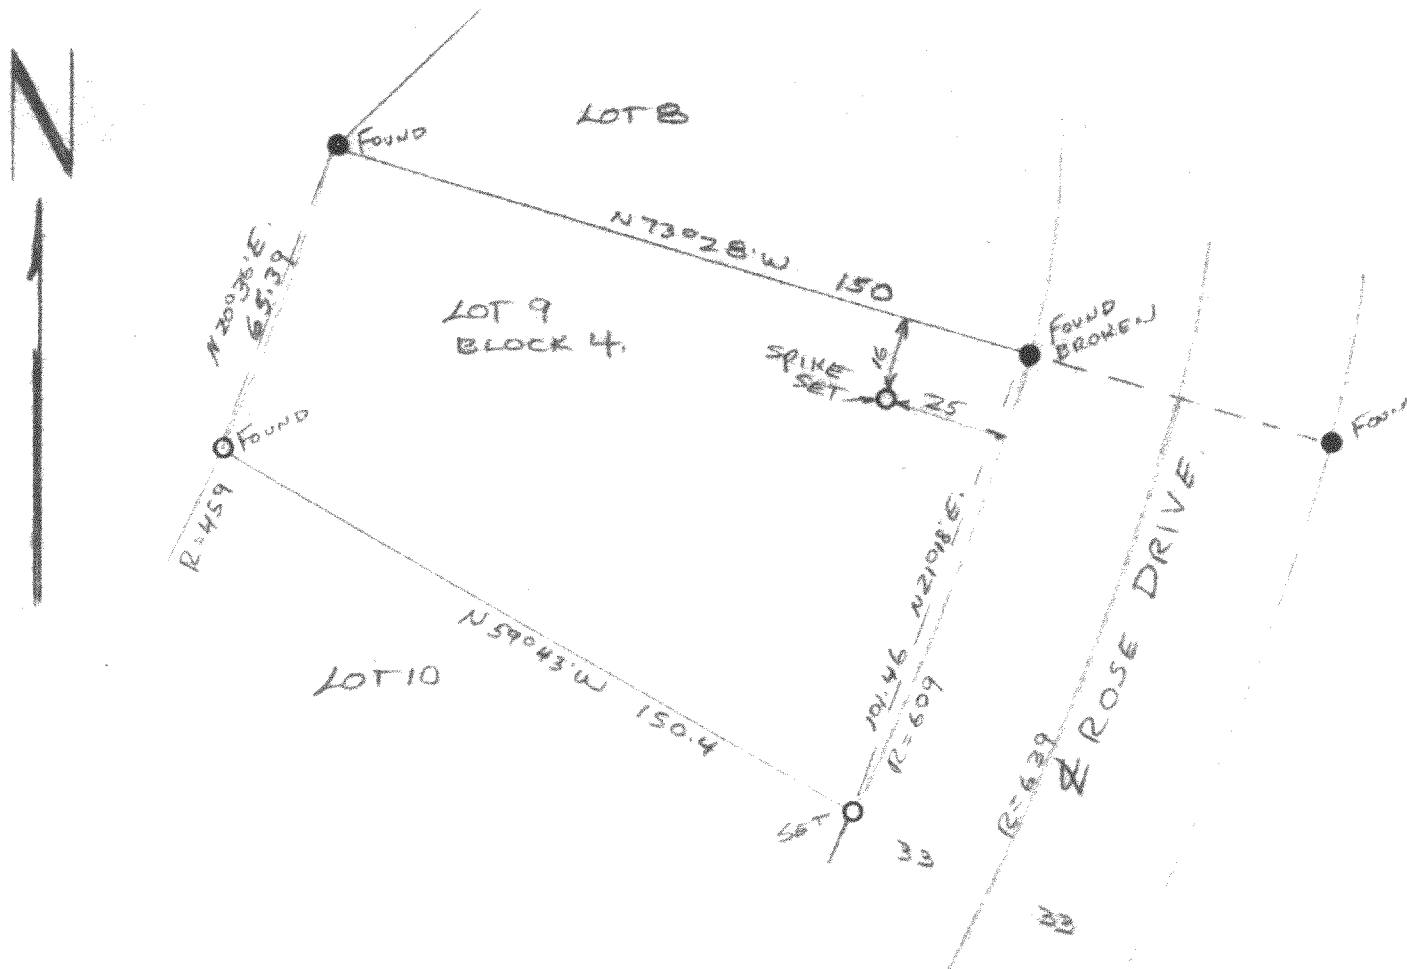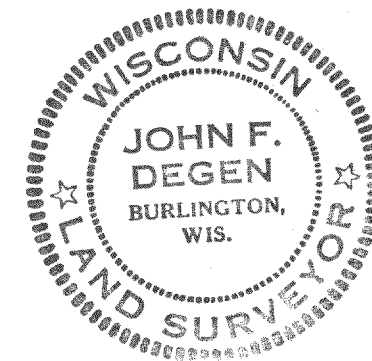

I have surveyed the above-described property, and the map hereon is a true representation thereof and shows the size and location of the property, its exterior boundaries, the location and dimensions of all visible structures thereon, fences, apparent easements and roadways and visible encroachments, if any.

This survey is made for the exclusive use of the present owners of the property, and also those who purchase, mortgage, or guarantee the title thereto, within one year from date hereof.

Dated at Burlington, this 12th day of DEC. 1978

John F. Degen
John F. Degen, Land Surveyor S-242

MRNG-32A

118-604✓