


FARRIS, HANSEN & COOPER, INC.

ENGINEERING, SURVEYING AND LAND PLANNING
715 W. WALWORTH ST. - P.O. Box 487 - ELKHORN, WI 53121
OFFICE: 414/723-2098

PLAT OF SURVEY OF: Lots 135 & 136 &
the West 40 feet of Lots 74-78 of Block
2 of Pell Lake Highlands, a subdivision
Located in Town 1 North, Range 18 East,
Walworth County, Wisconsin.

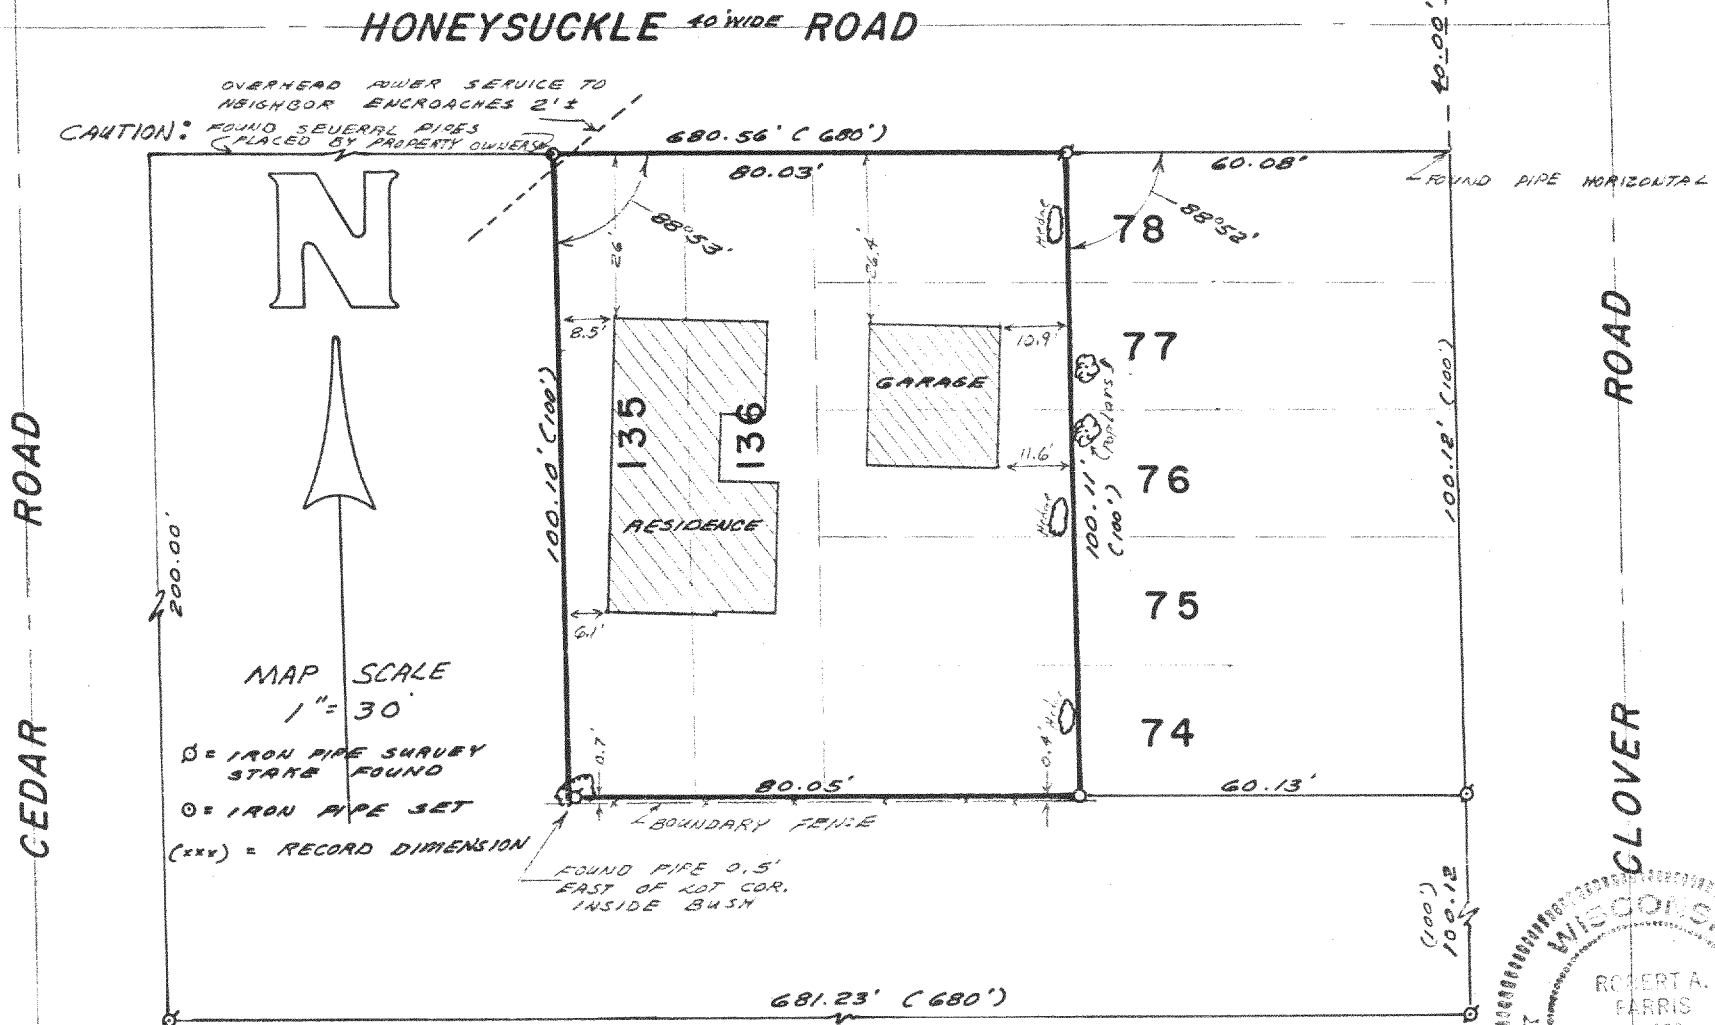


I HEREBY CERTIFY that I have surveyed the property hereon described and that this Plat of Survey is a true and accurate representation of the boundary and the structures located thereon to the best of my professional knowledge and belief.

Dated this 28th day of October, 1980

Robert A. Farris

DRAWING NUMBER 1774

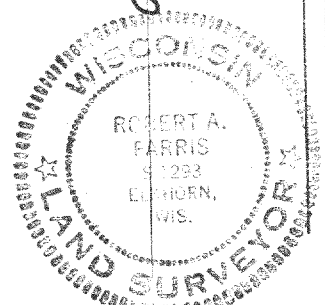

118-610-F