


KOLB LAND CONSULTING, INC.

LAND SURVEYING • SUBDIVIDING • LAND PLANNING


LAKE GENEVA, WISCONSIN 53147

WHITEWATER, WISCONSIN 53190

HAWTHORNE ROAD 40' WIDE

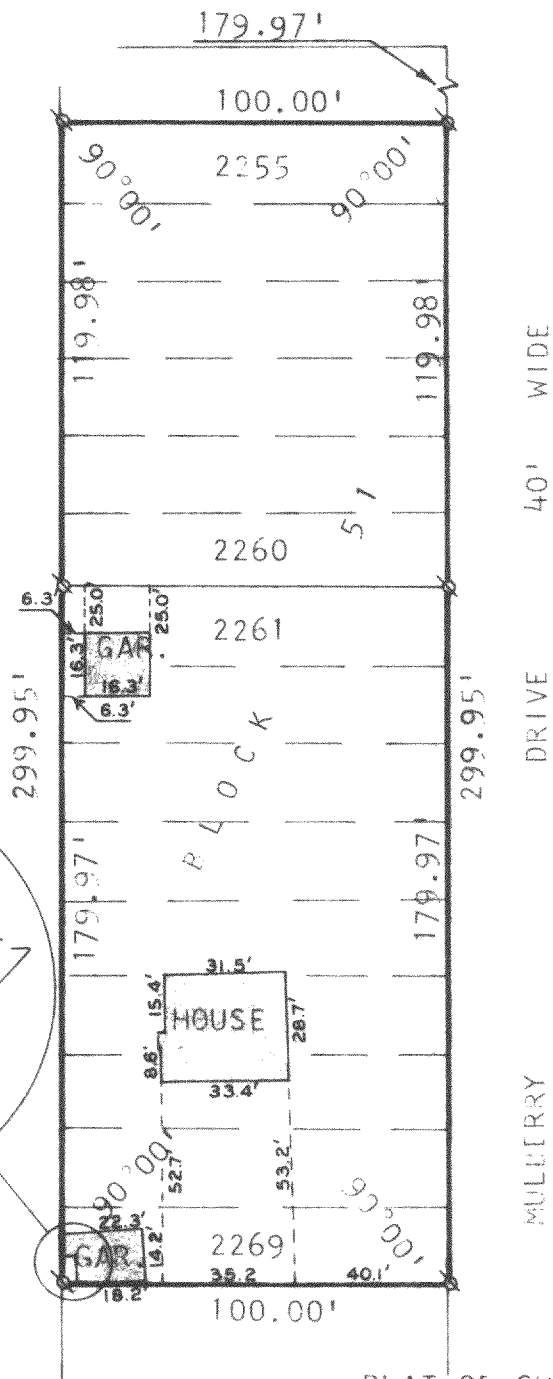

DETAIL
SCALE : 1"=10'

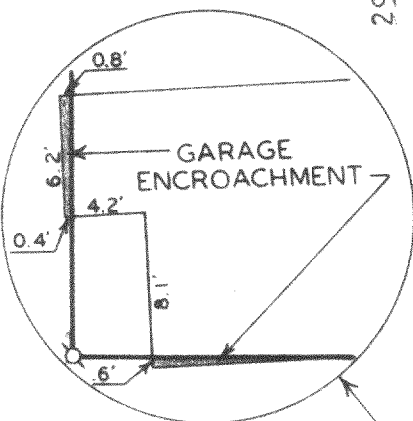

SCALE : 1"=50'

LEGEND

Q - IRON PIPE FOUND

ORDERED BY: RICHARD LEWANDOWSKI
4722 W. ALTGELD ST.
CHICAGO, ILL. 60639

PLAT OF SURVEY OF

LOTS 2255-2269, BLOCK 51, SECTION 2, PELL LAKE
SUBDIVISION, WALWORTH COUNTY, WISCONSIN.

I, ROBERT M. BAERENWALD, DO HEREBY CERTIFY THAT I
HAVE SURVEYED THE PROPERTY HEREON DESCRIBED ACCORD-
ING TO THE OFFICIAL RECORDS, AND THAT THE PLAT HERE-
ON IS A CORRECT REPRESENTATION OF THE LOT LINES TO
THE BEST OF MY KNOWLEDGE AND BELIEF.

ROBERT M. BAERENWALD
WISCONSIN REGISTERED LAND SURVEYOR, S-1508

DATE Sept 22 1994



118-613 K