


FARRIS, HANSEN & COOPER, INC.

ENGINEERING, SURVEYING AND LAND PLANNING
715 W. WALWORTH ST. - P.O. BOX 487 - ELKHORN, WI 53121

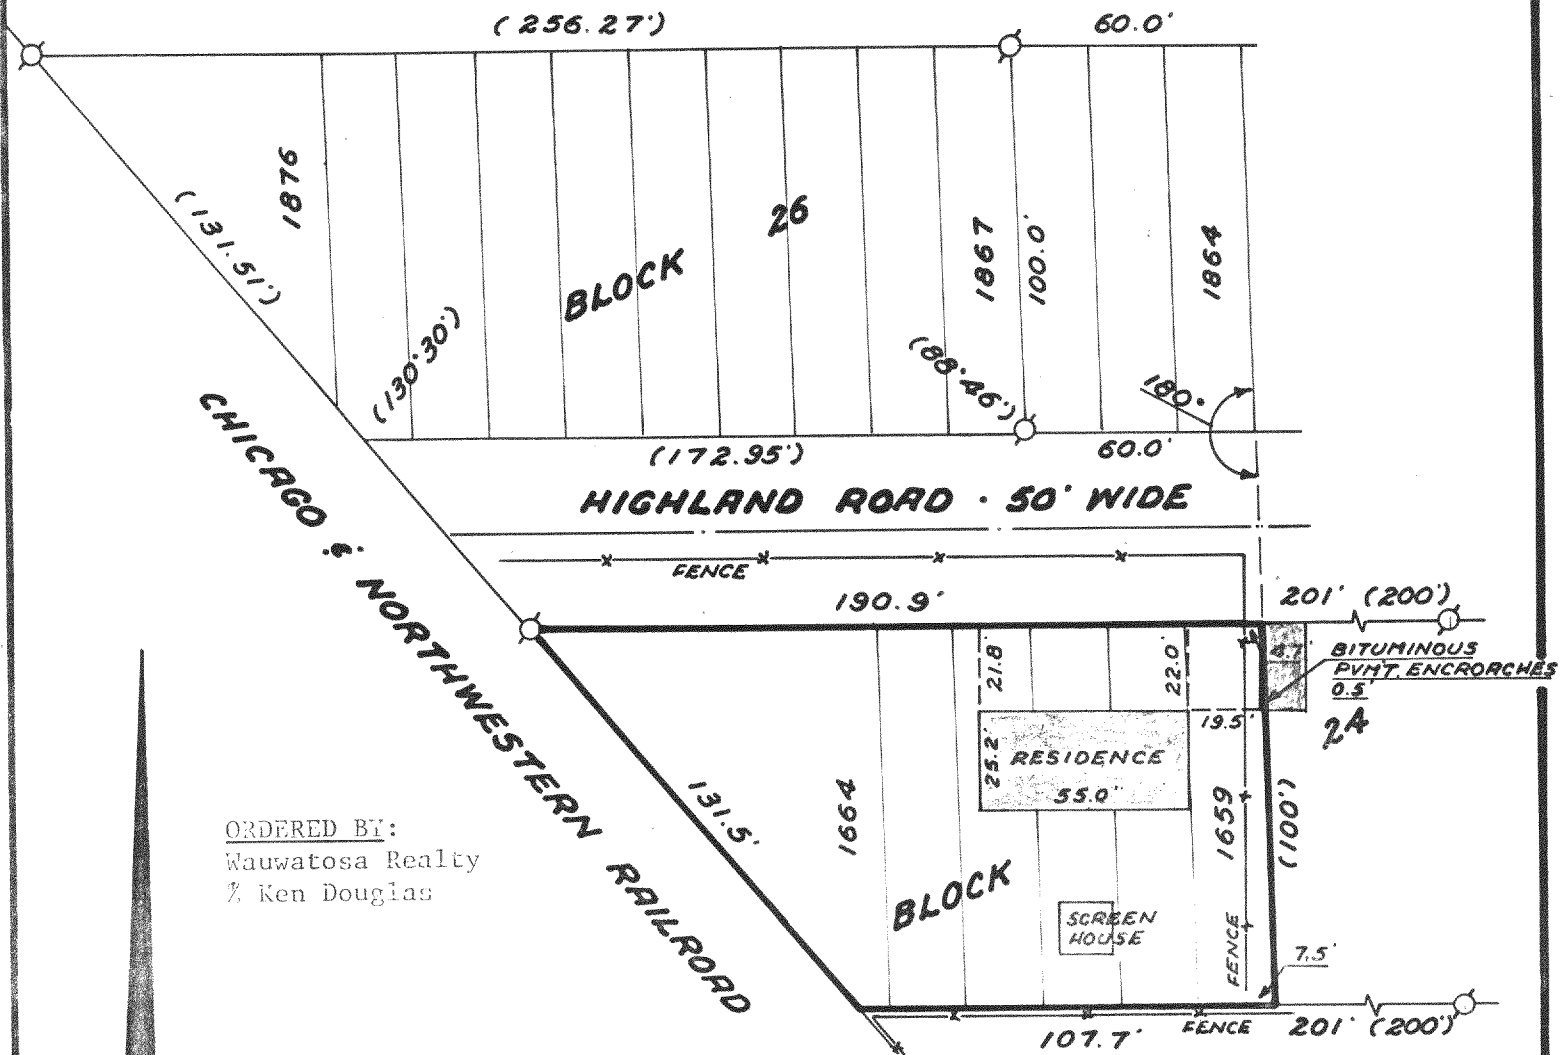

ORDERED BY:
Wauwatosa Realty
% Ken Douglas

MORTGAGE INSPECTION SURVEY

LOTS 1659-1664, BLOCK 24, PELL LAKE HIGHLANDS, LOCATED IN
SECTION 16, TOWN 1 NORTH, RANGE 18 EAST, TOWN OF BLOOMFIELD,
WALWORTH COUNTY, WISCONSIN.

NOTE: THIS IS NOT A "PROPERTY SURVEY" AS DEFINED IN SECTION
AE-5.01 OF THE WISCONSIN ADMINISTRATIVE CODE.


0 10 20 30 40 50



SCALE IN FEET
1" = 50'

LEGEND

- Iron Pipe Found
- ()—Record Dimension

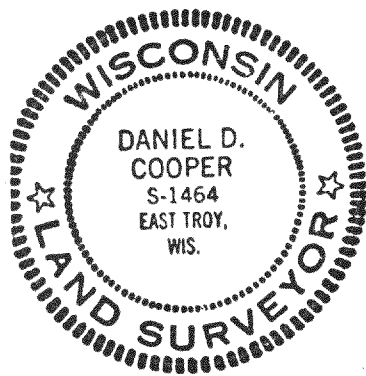

I HEREBY CERTIFY that this map is a true representation of the location of the structure with respect to the survey monuments indicated as found to the best of my knowledge and belief.

Daniel D. Cooper
Daniel D. Cooper, RLS No. 1464

Dated this 11 day of Oct 1979.

PROJ. NO. 1622

118-618