

PLAT OF SURVEY  
OF

LOTS 12 & 13, BLOCK 1, OF THE 8TH ADDITION TO NIPPERSINK PARK, A SUBDIVISION OF PART OF SECTION 24, T. 1 N.  
R. 18 E. OF THE 4TH P.M., TOWNSHIP OF BLOOMFIELD, COUNTY OF WALWORTH, STATE OF WISCONSIN.

FOR: BUEHN REALTY

SCALE 1" = 40'

o = IRON PIPE STAKE FOUND

BEARINGS ARE RELATIVE TO THE PUBLIC ROAD WHICH  
WAS PLATTED AS N. 30°44' W.


o = PIPE SET



I have surveyed the above-described prop  
and the map hereon is a true representa  
thereof and shows the size and location of  
property, its exterior boundaries, the loca  
and dimensions of all visible structures ther  
fences, apparent easements and roadway, a  
visible encroachments, if any.

This survey is made for the exclusive use of  
the present owners of the property, and als  
those who purchase, mortgage, or guarante  
the due thereto, within one year from day  
hereof.

Dated at Burlington, this 6th day  
of AUGUST 1975  
*John F. Degen*  
John F. Degen, Land Surveyor S 242  
RE-SURVEYED 8-4-80

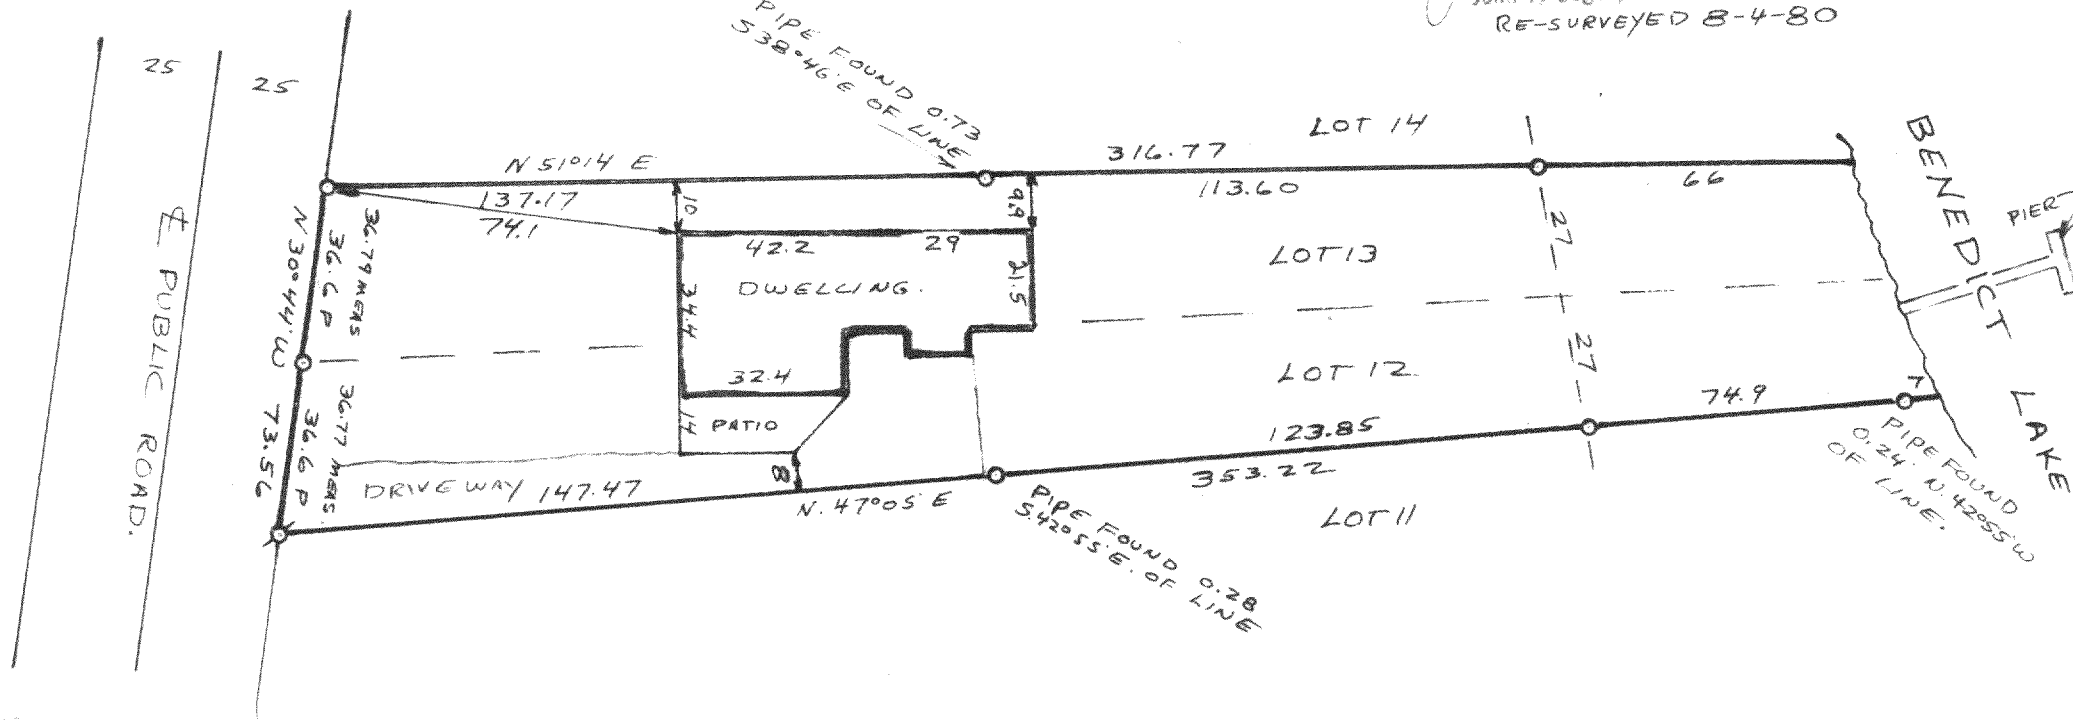

20  
MNPS8-75

118-629D JFD 8-8-75 DRAWER 6-0-3-10