


FARRIS, HANSEN & COOPER, INC.

ENGINEERING, SURVEYING AND LAND PLANNING
715 W. WALWORTH ST. - P.O. BOX 487 - ELKHORN, WI 53121

POST ROAD - 50' WIDE

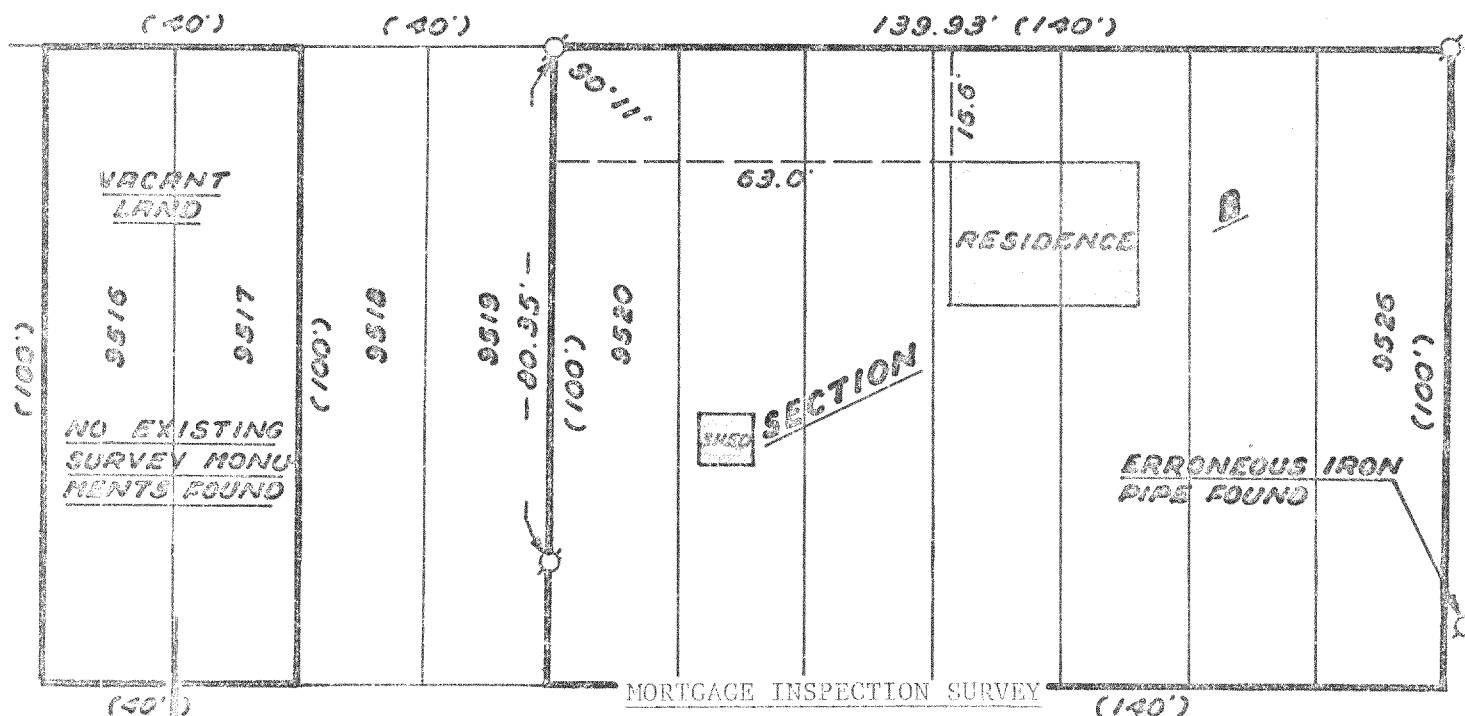

LOTS 9516, 9517, AND 9520-9526, SECTION B, PELL LAKE SUBDIVISION, SECTION 22, TOWN 1 NORTH, RANGE 18 EAST, TOWN OF BLOOMFIELD, WALWORTH COUNTY, WISCONSIN.

NOTE: THIS IS NOT A "PROPERTY SURVEY" AS DEFINED IN SECTION AE-5.01 OF THE WISCONSIN ADMINISTRATIVE CODE.


ORDERED BY: Universal Mortgage
%Judy Jasiciel

BUYER: Lawrence DeCota

0 10 20 30
SCALE IN FEET
1"=30'

LEGEND

- ⊗ - Iron Pipe Found
- () - Record Dimension

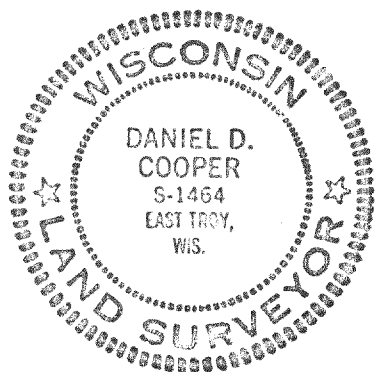

I HEREBY CERTIFY that this map is a true representation of the location of the structures with respect to the survey monuments indicated as found to the best of my knowledge and belief.

Daniel D. Cooper
Daniel D. Cooper, RLS No. 1464

Dated this 15 day of Nov, 1979.

Sheet 1 of 2
PROJECT NO. 1637

118-624