


KOLB LAND CONSULTING, INC.
LAND SURVEYING • SUBDIVIDING • LAND PLANNING

LAKE GENEVA, WISCONSIN 53147


WHITEWATER, WISCONSIN 53190

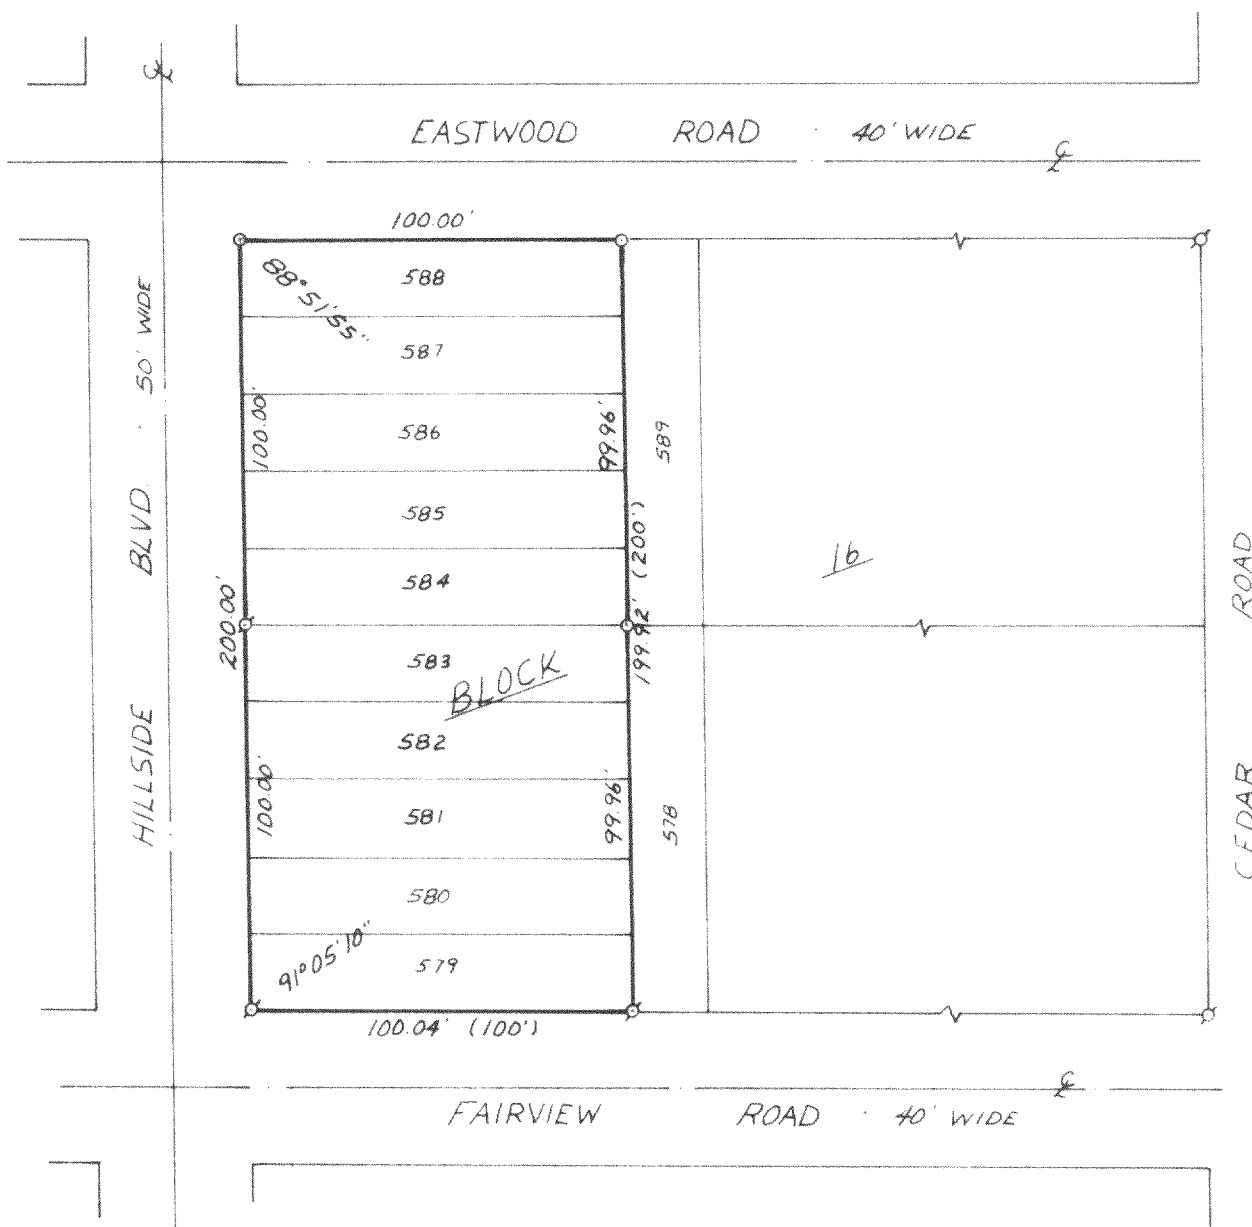

PLAT OF SURVEY OF

LOTS 579-588, BLOCK 16, PELL LAKE HIGHLANDS,
TOWN OF RIX, WALWORTH COUNTY, WISCONSIN.

ORDERED BY: WALTER FITCHEN

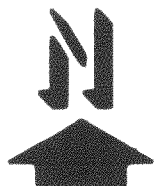

SCALE - 1"=50'

LEGEND

- ø - IRON PIPE FOUND
- o - IRON PIPE SET
- () - RECORDED AS

I, HAROLD H. KOLB, DO HEREBY CERTIFY
THAT I HAVE SURVEYED THE PROPERTY
HEREON DESCRIBED ACCORDING TO THE
OFFICIAL RECORDS, AND THAT THE PLAT
HEREON IS A CORRECT REPRESENTATION
OF THE LOT LINES TO THE BEST OF MY
KNOWLEDGE AND BELIEF.

Harold H. Kolb

HAROLD H. KOLB
WISCONSIN REGISTERED LAND SURVEYOR, S-187

DATE Sept. 24, 1981

118-628-K