

KOLB LAND CONSULTING, INC.
LAND SURVEYING • SUBDIVIDING • LAND PLANNING

LAKE GENEVA, WISCONSIN 53147

WHITEWATER, WISCONSIN 53190

POINSETTA

ROAD

50' WIDE

(N87°31'E)

COURT A

30' WIDE

R=25'

PARK

(S42°53'00"E)

40' WIDE

ROAD

BLOCK

164


ZINIA ROAD

40' WIDE

PLAT OF SURVEY OF


LOTS 8599-8601, BLOCK 164, PELL LAKE
SUBDIVISION, LOCATED IN T 1 N, R 18 E,
WALWORTH COUNTY, WISCONSIN.

ORDERED BY: CHAS. BAHRENS
W1271 POINSETTA
PELL, LAKE, WISCONSIN 53147

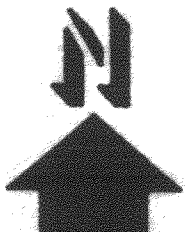

SCALE: 1"=40'

⊘ - IRON PIPE FOUND
○ - IRON PIPE PLACED
() - RECORDED AS

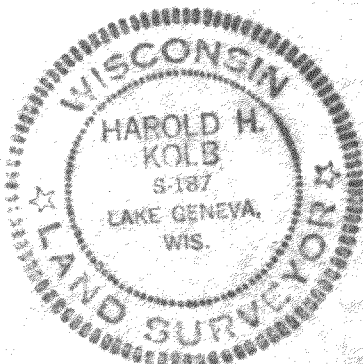

I, HAROLD H. KOLB, DO HEREBY CERTIFY
THAT I HAVE SURVEYED THE PROPERTY
HEREON DESCRIBED ACCORDING TO THE
OFFICIAL RECORDS, AND THAT THE PLAT
HEREON IS A CORRECT REPRESENTATION
OF THE LOT LINES TO THE BEST OF MY
KNOWLEDGE AND BELIEF.

Harold H. Kolb

HAROLD H. KOLB

WISCONSIN REGISTERED LAND SURVEYOR, S- 187

DATE Oct. 19, 1981

118-630-KV