


I CERTIFY THAT I HAVE SURVEYED
THE ABOVE DESCRIBED LAND ACCORDING
TO THE OFFICIAL RECORDS & LOCATED THE
BUILDINGS THEREON. A

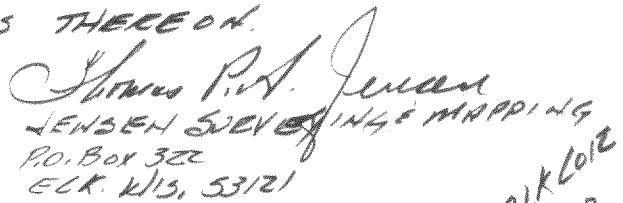

- ~ IRON PIPE
- ~ IRON ROD $\frac{3}{4}$ " JET
- () ~ RECORDED AS

SURVEYED FOR: GROOTENAT
735 N. MILWAUKEE
MILWAUKEE, WIS
53202