


KOLB LAND CONSULTING, INC.
LAND SURVEYING • SUBDIVIDING • LAND PLANNING

LAKE GENEVA, WISCONSIN 53147

WHITEWATER, WISCONSIN 53190

BERENICE ROAD


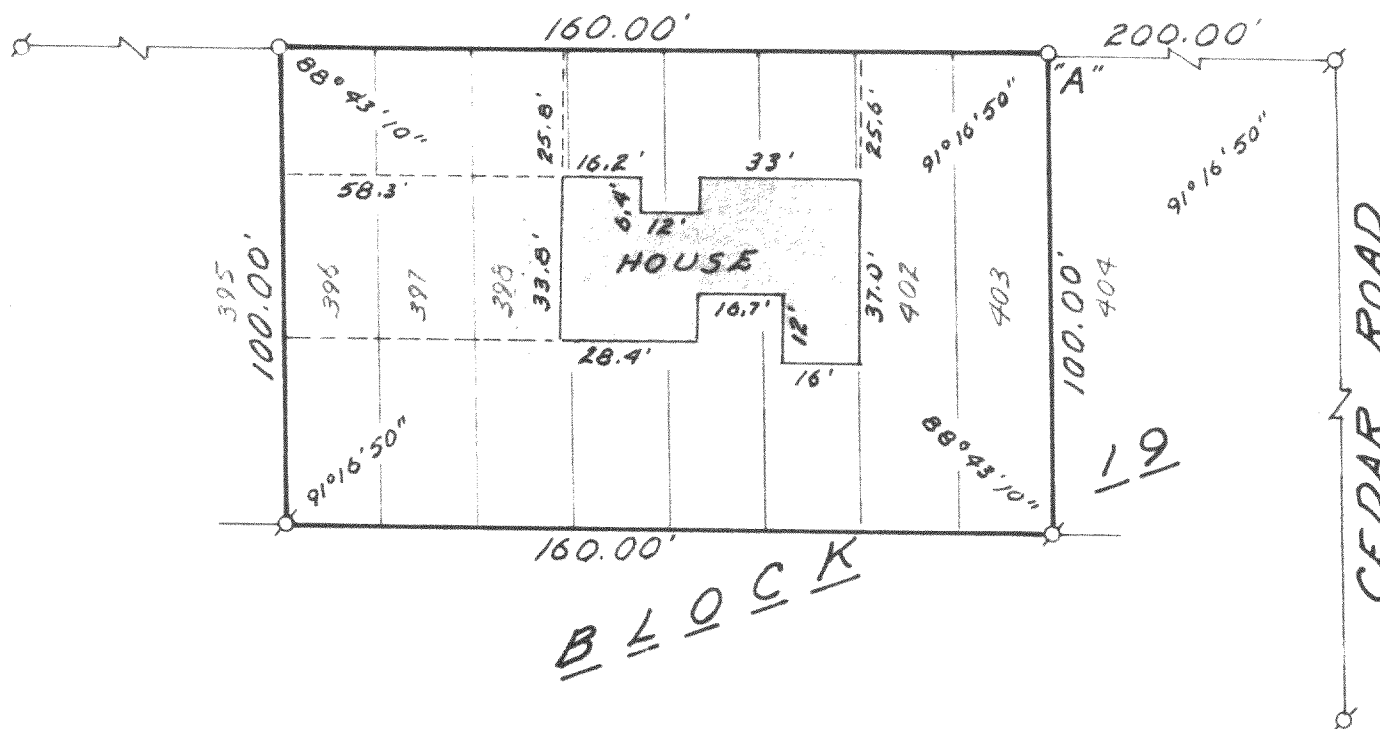


PLAT OF SURVEY OF

LOTS 396-403, BLOCK 19, PELL LAKE HIGHLANDS, LOCATED IN THE SOUTHEAST 1/4 OF SECTION 16, T 1 N, R 18 E, TOWN OF BLOOMFIELD, WALWORTH COUNTY, WISCONSIN.

ORDERED BY: LAKE GENEVA REALTY
737 MAIN STREET
LAKE GENEVA, WI. 53147

DETAIL "A"

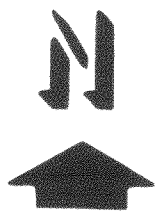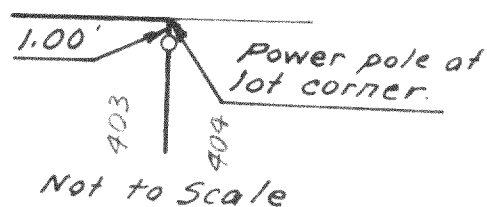

SCALE: 1"=40'

LEGEND

- IRON PIPE SET
- ⊗ IRON PIPE FOUND

I HAROLD H. KOLB, DO HEREBY CERTIFY THAT I HAVE SURVEYED THE PROPERTY HEREON DESCRIBED ACCORDING TO THE OFFICIAL RECORDS, AND THAT THE PLAT HEREON IS A CORRECT REPRESENTATION OF THE LOT LINES AND THE PRINCIPAL LINES OF THE BUILDINGS THEREON TO THE BEST OF KNOWLEDGE AND BELIEF.

Harold H. Kolb

WISCONSIN REGISTERED LAND SURVEYOR, S-187
DATE NOVEMBER 19, 1982



118-638-K