


KOLB LAND CONSULTING, INC.
LAND SURVEYING • SUBDIVIDING • LAND PLANNING

LAKE GENEVA, WISCONSIN 53147

WHITEWATER, WISCONSIN 53190

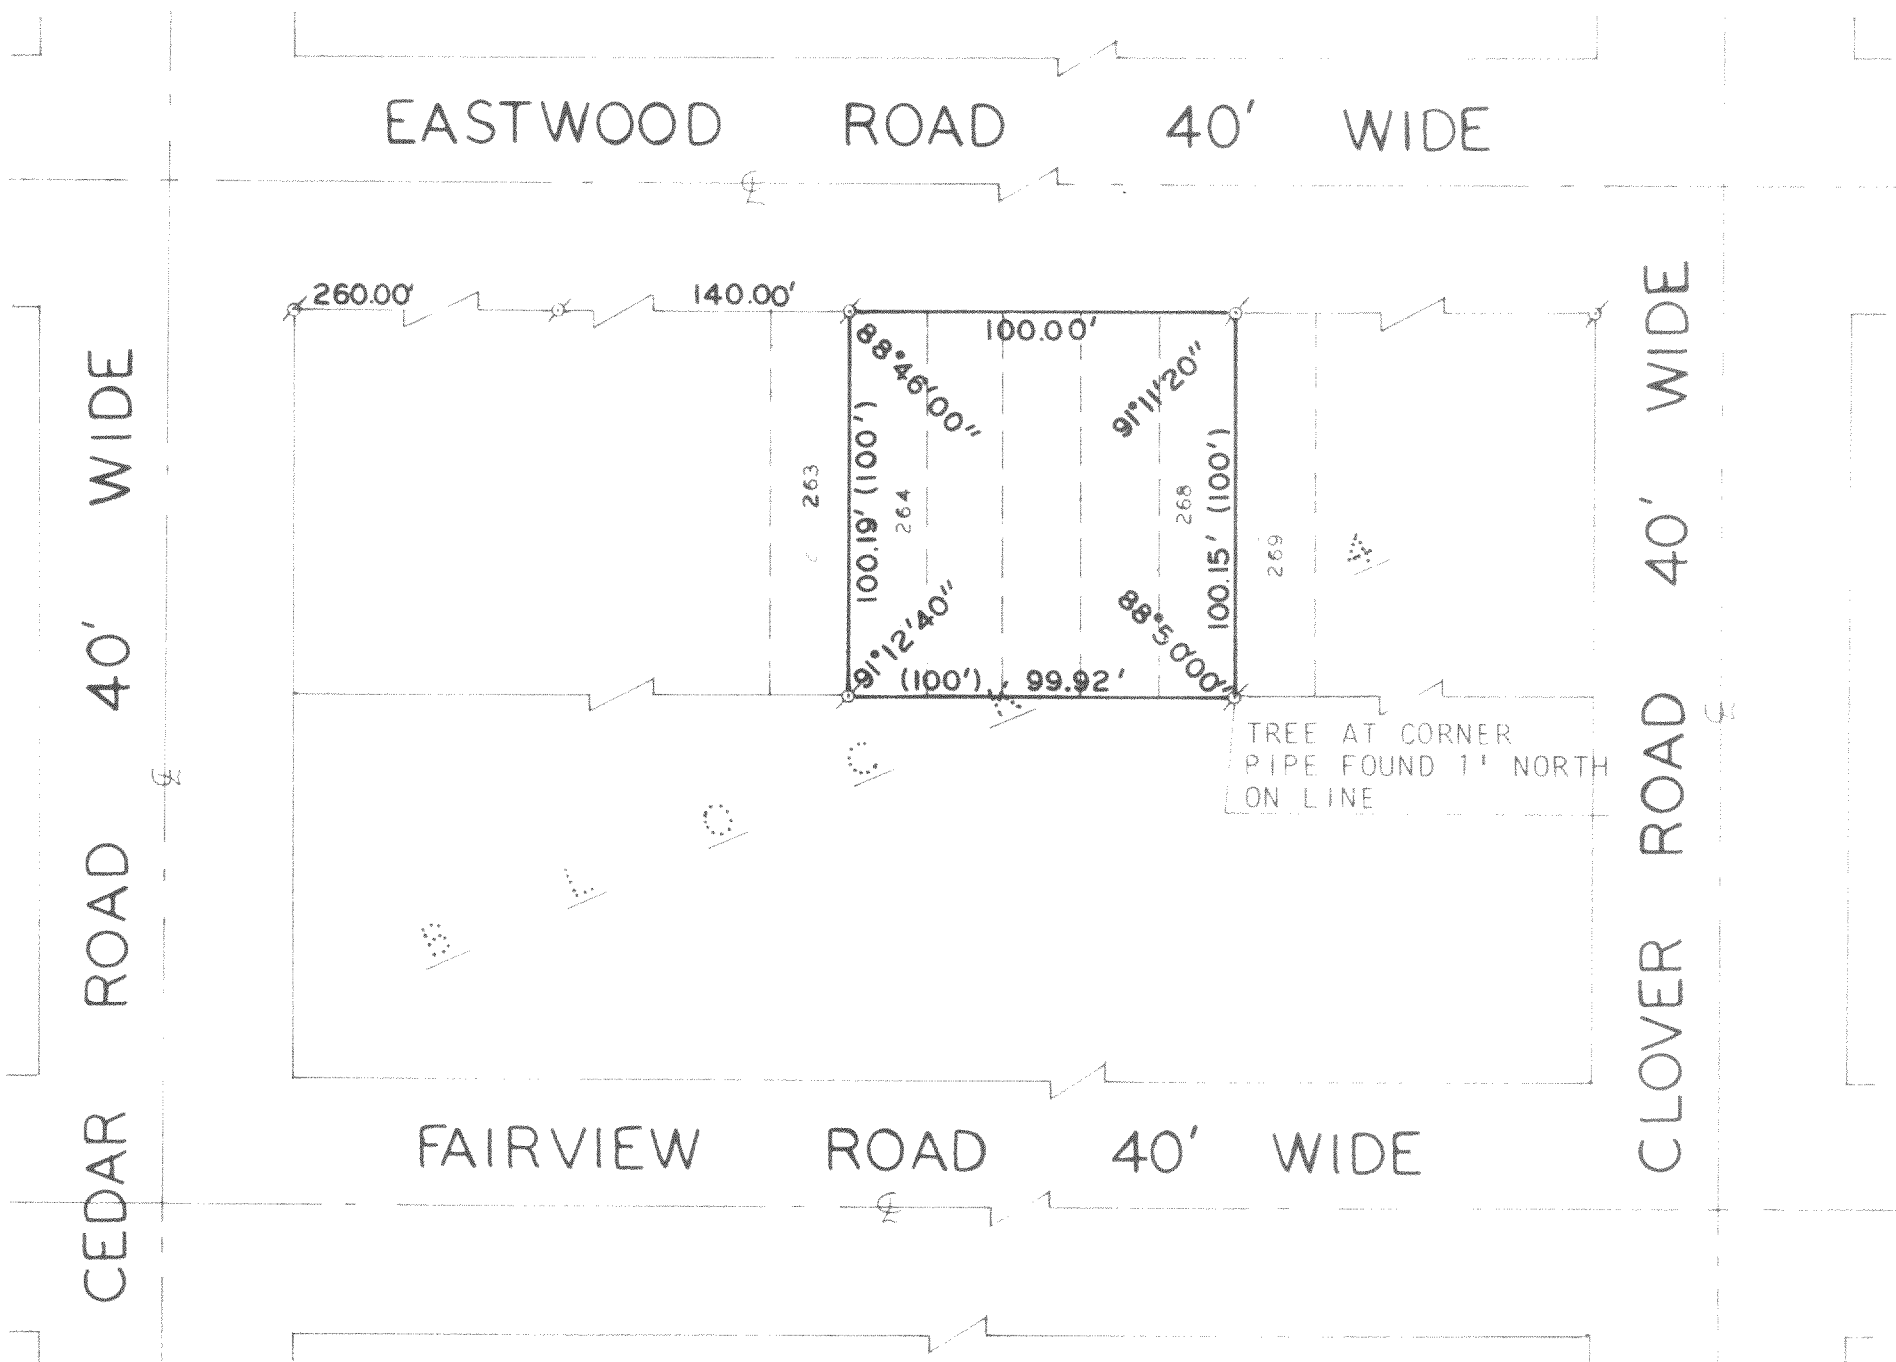

PLAT OF SURVEY OF


LOTS 264-268, BLOCK 4, PELL LAKE
HIGHLANDS, WALWORTH COUNTY,
WISCONSIN.

ORDERED BY: PAUL KURLAK
2617 W. WALTON ST.
CHICAGO, ILL. 60622

I, HAROLD H. KOLB, DO HEREBY CERTIFY THAT
I HAVE SURVEYED THE PROPERTY HEREON
DESCRIBED ACCORDING TO THE OFFICIAL RECORDS
AND THAT THE PLAT HEREON IS A CORRECT
REPRESENTATION OF THE LOT LINES TO THE
BEST OF MY KNOWLEDGE AND BELIEF.

SCALE 1"=50'

LEGEND:
⊗ - FOUND IRON PIPE
() - AS PLATTED

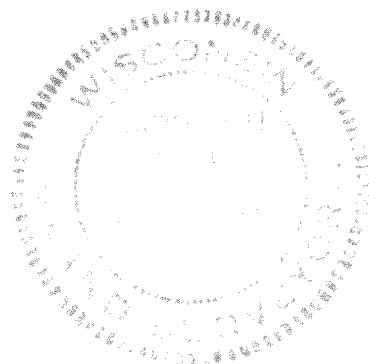

Harold H. Kolb
HAROLD H. KOLB
WISCONSIN REGISTERED LAND SURVEYOR, S-187
DATE May 28, 1981

118-639V