


KOLB LAND CONSULTING, INC.
LAND SURVEYING • SUBDIVIDING • LAND PLANNING

LAKE GENEVA, WISCONSIN 53147

WHITEWATER, WISCONSIN 53190


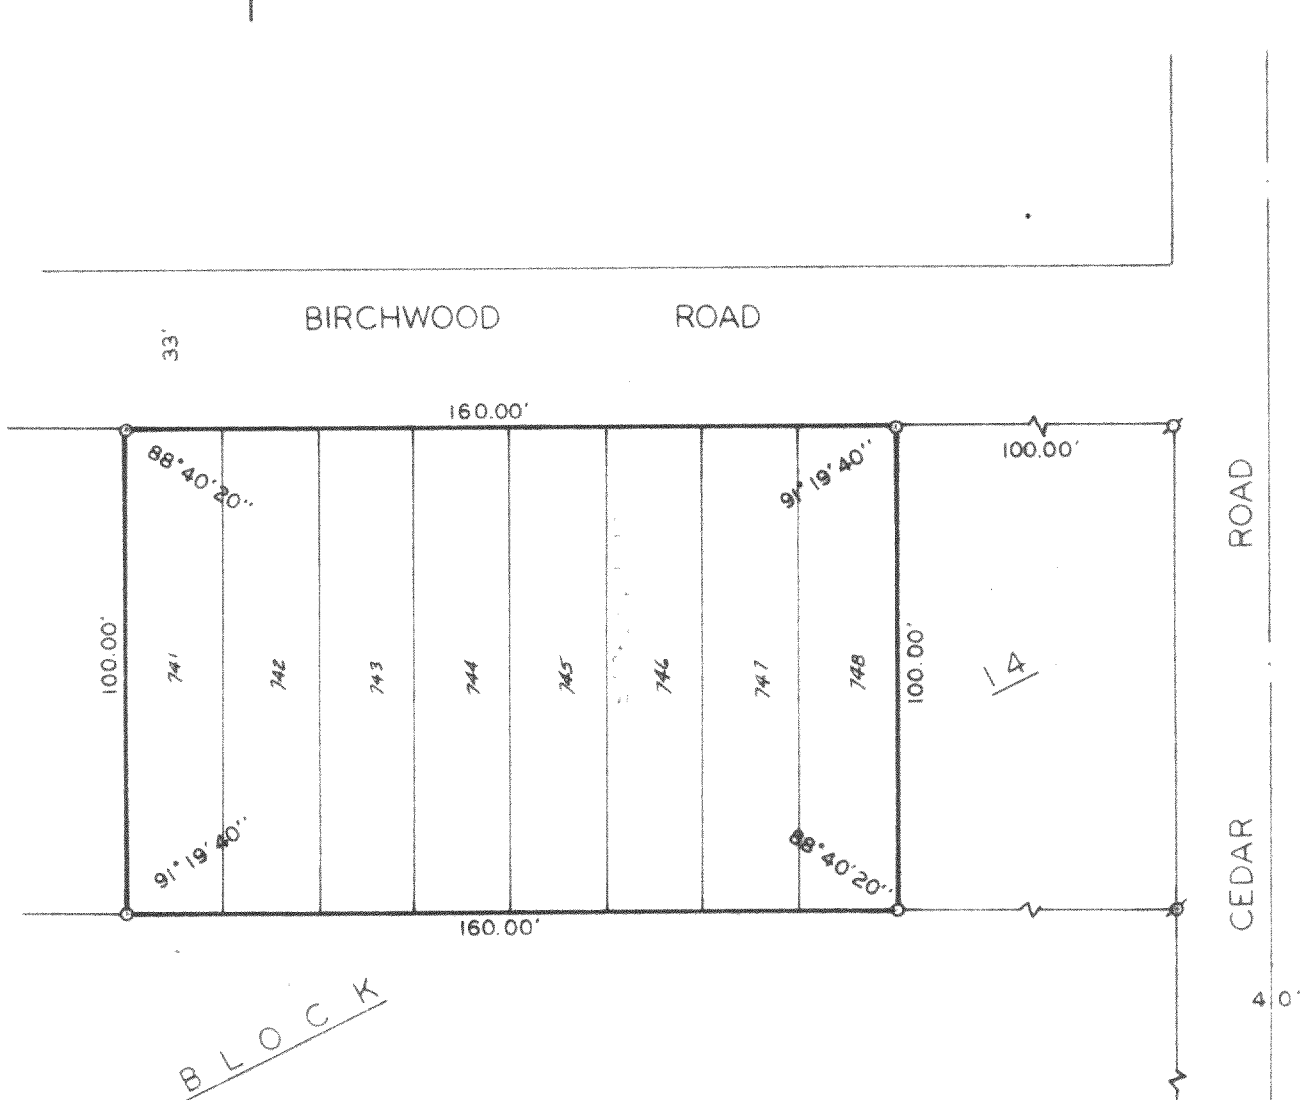


PLAT OF SURVEY OF

LOTS 741-748, BLOCK 14, PELL LAKE
HIGHLANDS, TOWN 1 NORTH, RANGE 18
EAST, WALWORTH COUNTY, WISCONSIN.

OWNER: AL & MAYME GEIST
14040 CHELSEA BLVD.
ORLAND PARK, IL 60402

ORDERED BY: VINCE GENATEMPO

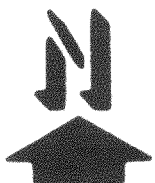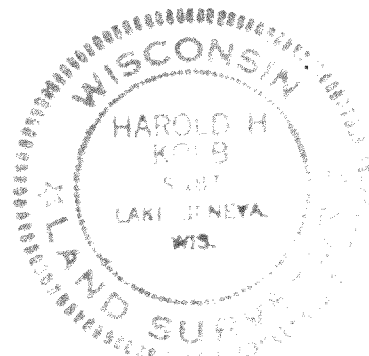

SCALE 1" = 40'

LEGEND

- ⊗ - IRON PIPE FOUND
- - IRON PIPE SET

I, HAROLD H. KOLB, DO HEREBY CERTIFY
THAT I HAVE SURVEYED THE PROPERTY
HEREON DESCRIBED ACCORDING TO THE
OFFICIAL RECORDS, AND THAT THE PLAT
HEREON IS A CORRECT REPRESENTATION
OF THE LOT LINES TO THE BEST OF MY
KNOWLEDGE AND BELIEF.

Harold H. Kolb

HAROLD H. KOLB
WISCONSIN REGISTERED LAND SURVEYOR, S-187

DATE Sept. 28, 1982

MPLH-160 +161

118-639-K