


LOTS 1287 TO 1291, INCLUSIVELY, BLOCK 29,
AND LOTS 1216 TO 1225, INCLUSIVELY, BLOCK 27,
IN SECTION 1 TO PELL LAKE, A SUBDIVISION
LOCATED IN THE NE $\frac{1}{4}$ OF SECTION 21, T1N
R16E, W44E, CO. LIS.

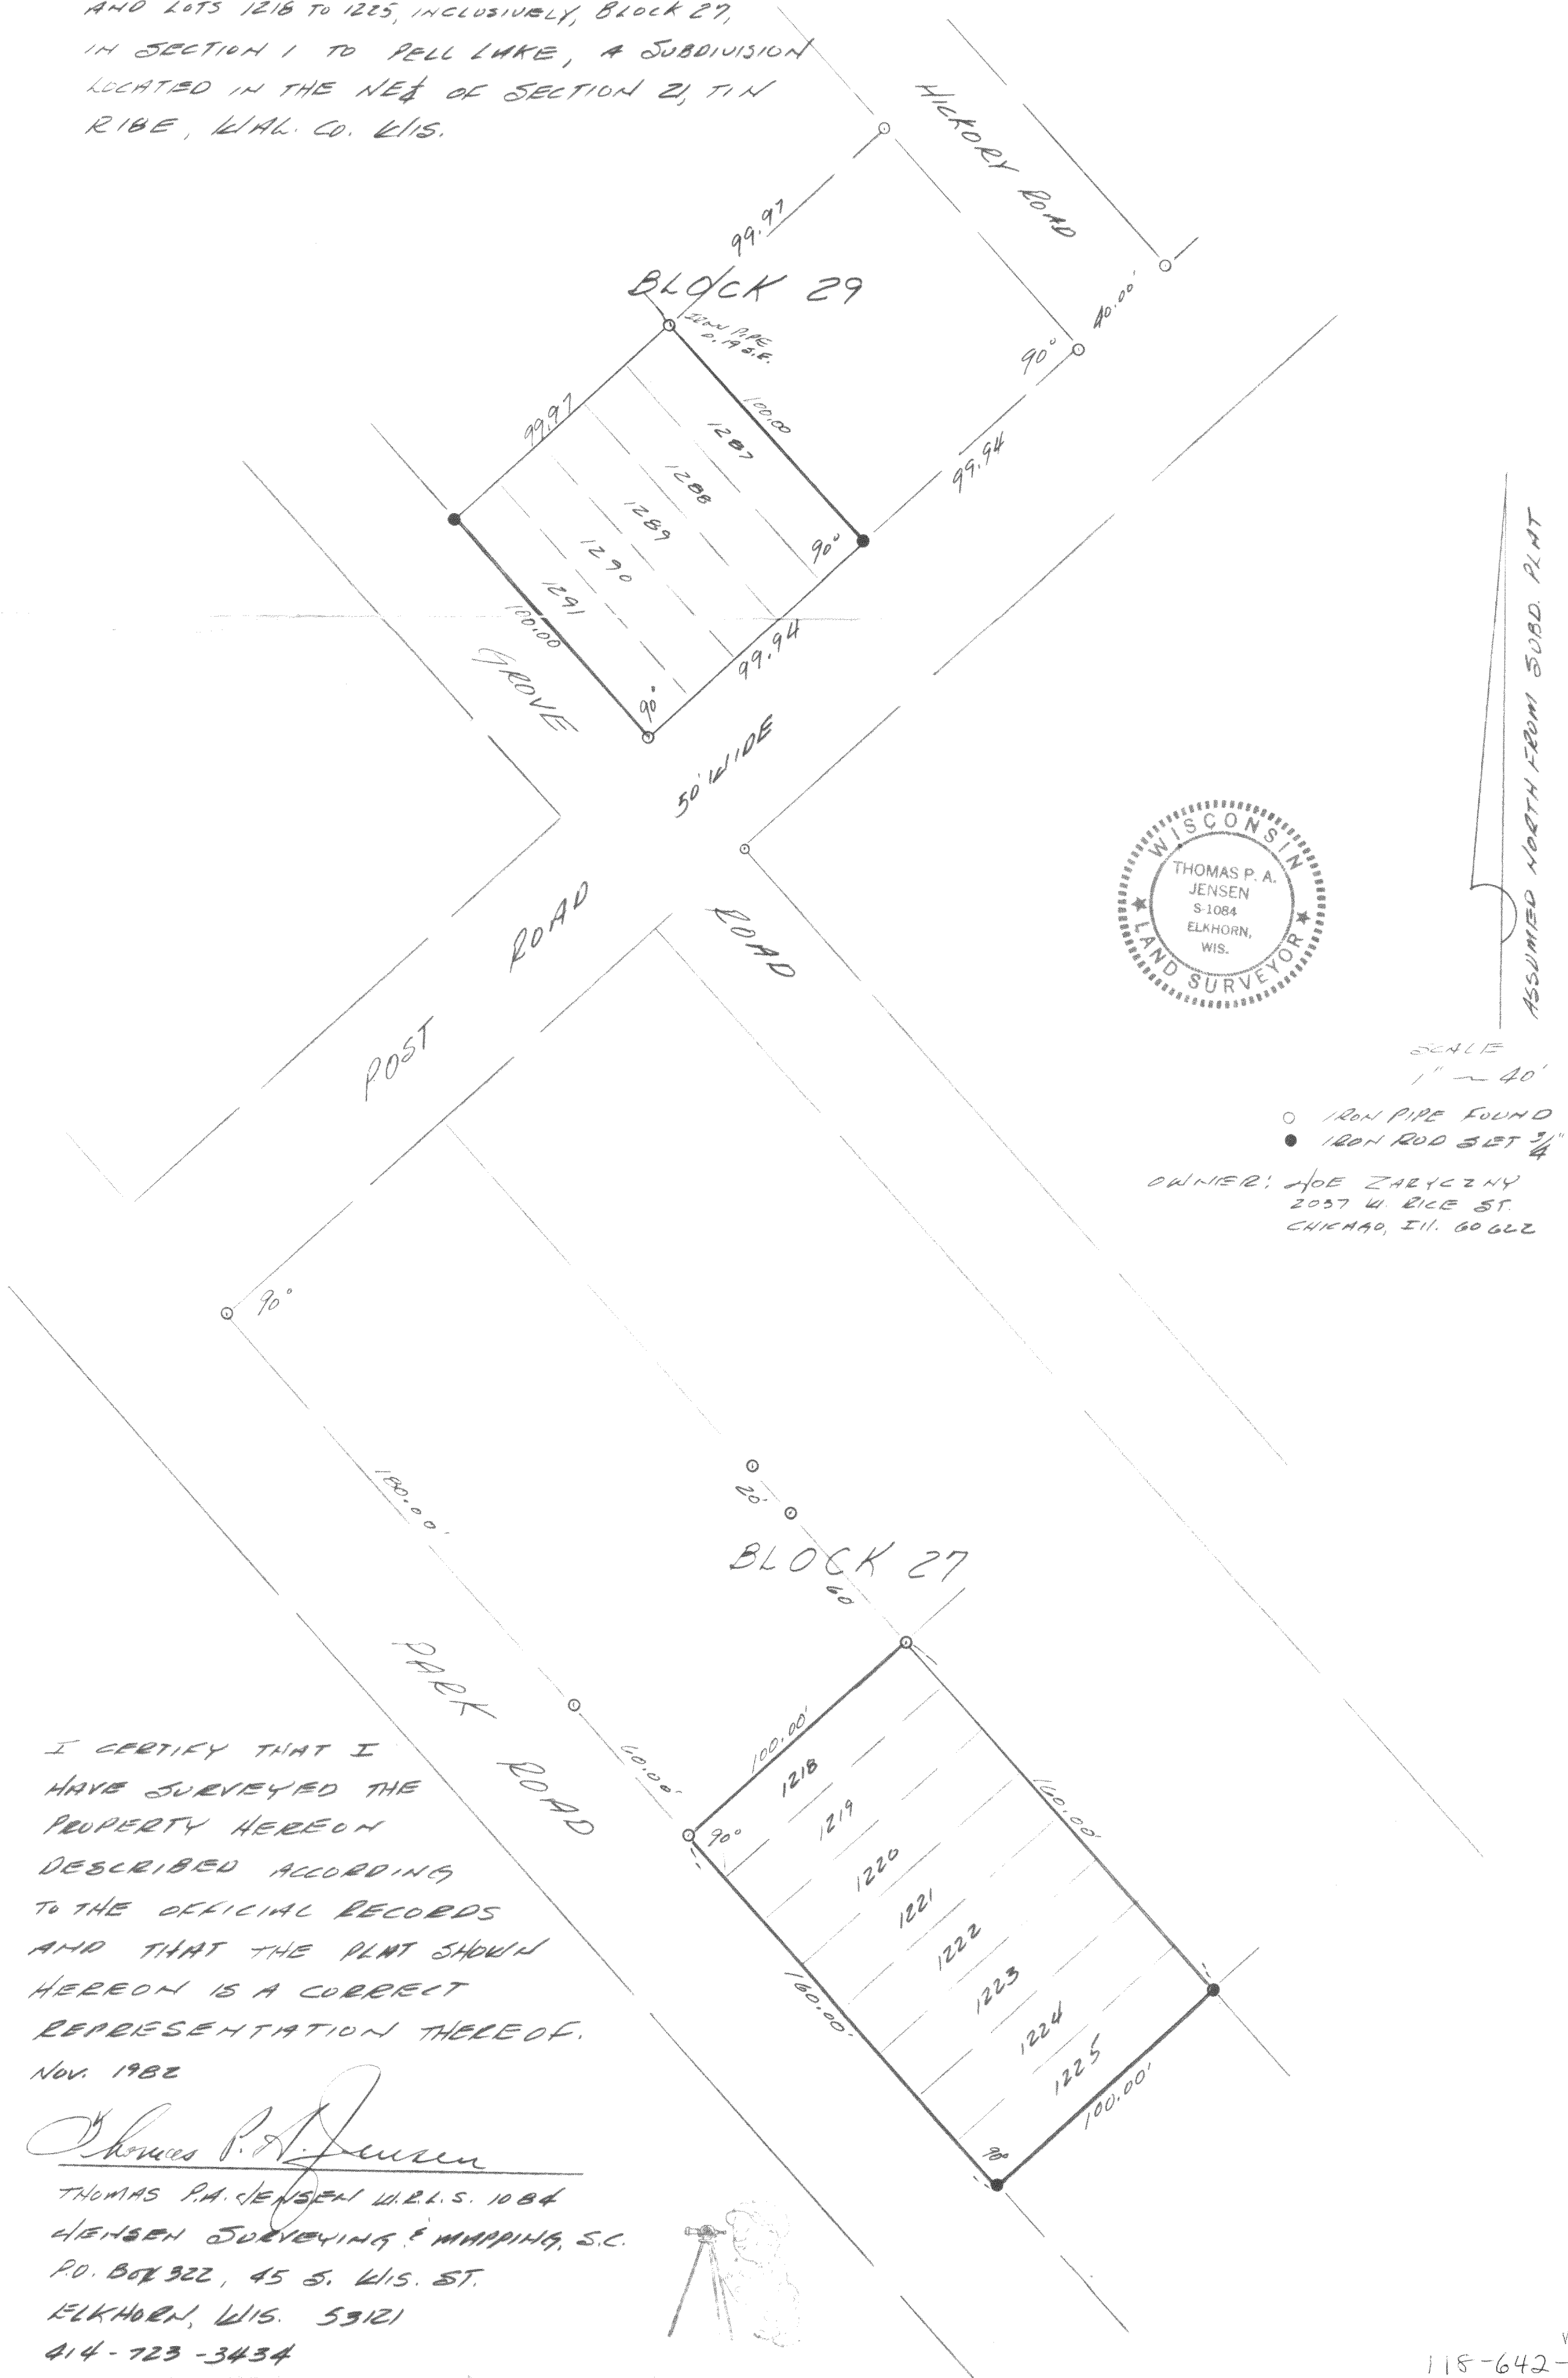


I CERTIFY THAT I
HAVE SURVEYED THE
PROPERTY HEREON
DESCRIBED ACCORDING
TO THE OFFICIAL RECORDS
AND THAT THE PLAT SHOWN
HEREON IS A CORRECT
REPRESENTATION THEREOF.

Nov. 1982

Thomas P. Jensen

THOMAS P.H. JENSEN W.R.L.S. 1084
JENSEN SURVEYING & MAPPING, S.C.
P.O. BOX 322, 45 S. WIS. ST.
ELKHORN, WIS. 53121
414-723-3434

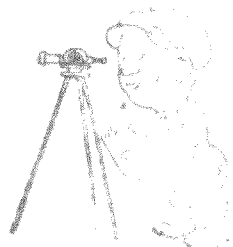

118-642-J