


Farris, Hansen & Associates, Inc.

Engineering, Surveying & Land Planning

P.O. BOX 487

715 W. WALWORTH STREET
ELKHORN, WISCONSIN 53121

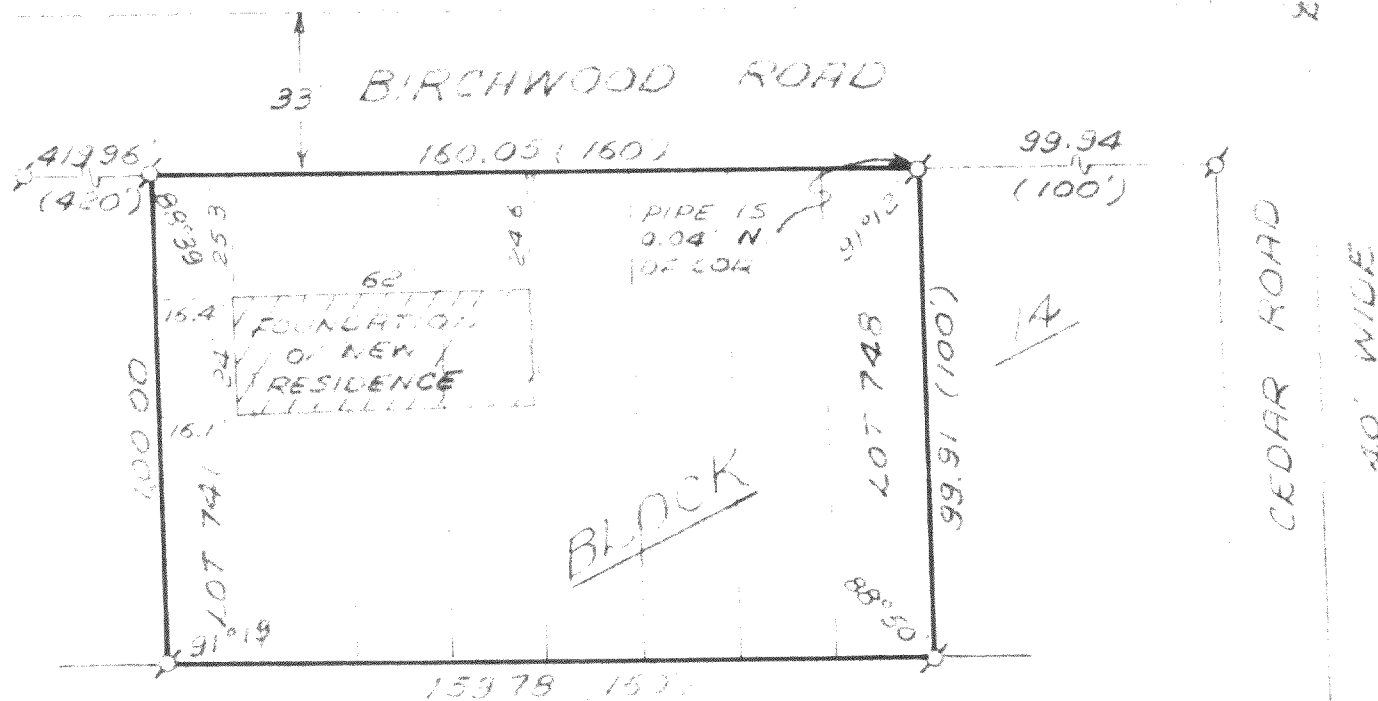

LEGEND

⊗ — IRON PIPE
SURVEY STAKE
FOUND

() — RECORD
DIMENSION

1" = 40'

WORK ORDERED BY: Larry Schauder
For Knutson Mortgage Co., Beloit, WI
(BUYER: Mr. & Mrs. Conatempo)

PLAT OF SURVEY OF

LOTS 741-748, BLOCK 14, PEL LAKE
HIGHLANDS, T 1 N., R 18 E., WALWORTH
COUNTY WISCONSIN.



I hereby certify that I have surveyed the above described property and that the above map is a true representation thereof and shows the size and location of the property, its exterior boundaries, the location of all visible structures and dimensions of all principal buildings thereon, boundary fences, apparent easements, roadways and visible encroachments, if any.

This survey is made for the use of the present owners of the property, and also those who purchase, mortgage, or guarantee the title thereto within one (1) year from date hereof.

Robert A. Farris
Robert A. Farris, RLS

Dated this 10th day of May, 1983

DRAWING NUMBER 2103

PLH-1603-PLH-161

118-644-F