


DUNHAM & RASMUSSEN
SURVEYING & ENGINEERING
DELAVER, WISCONSIN

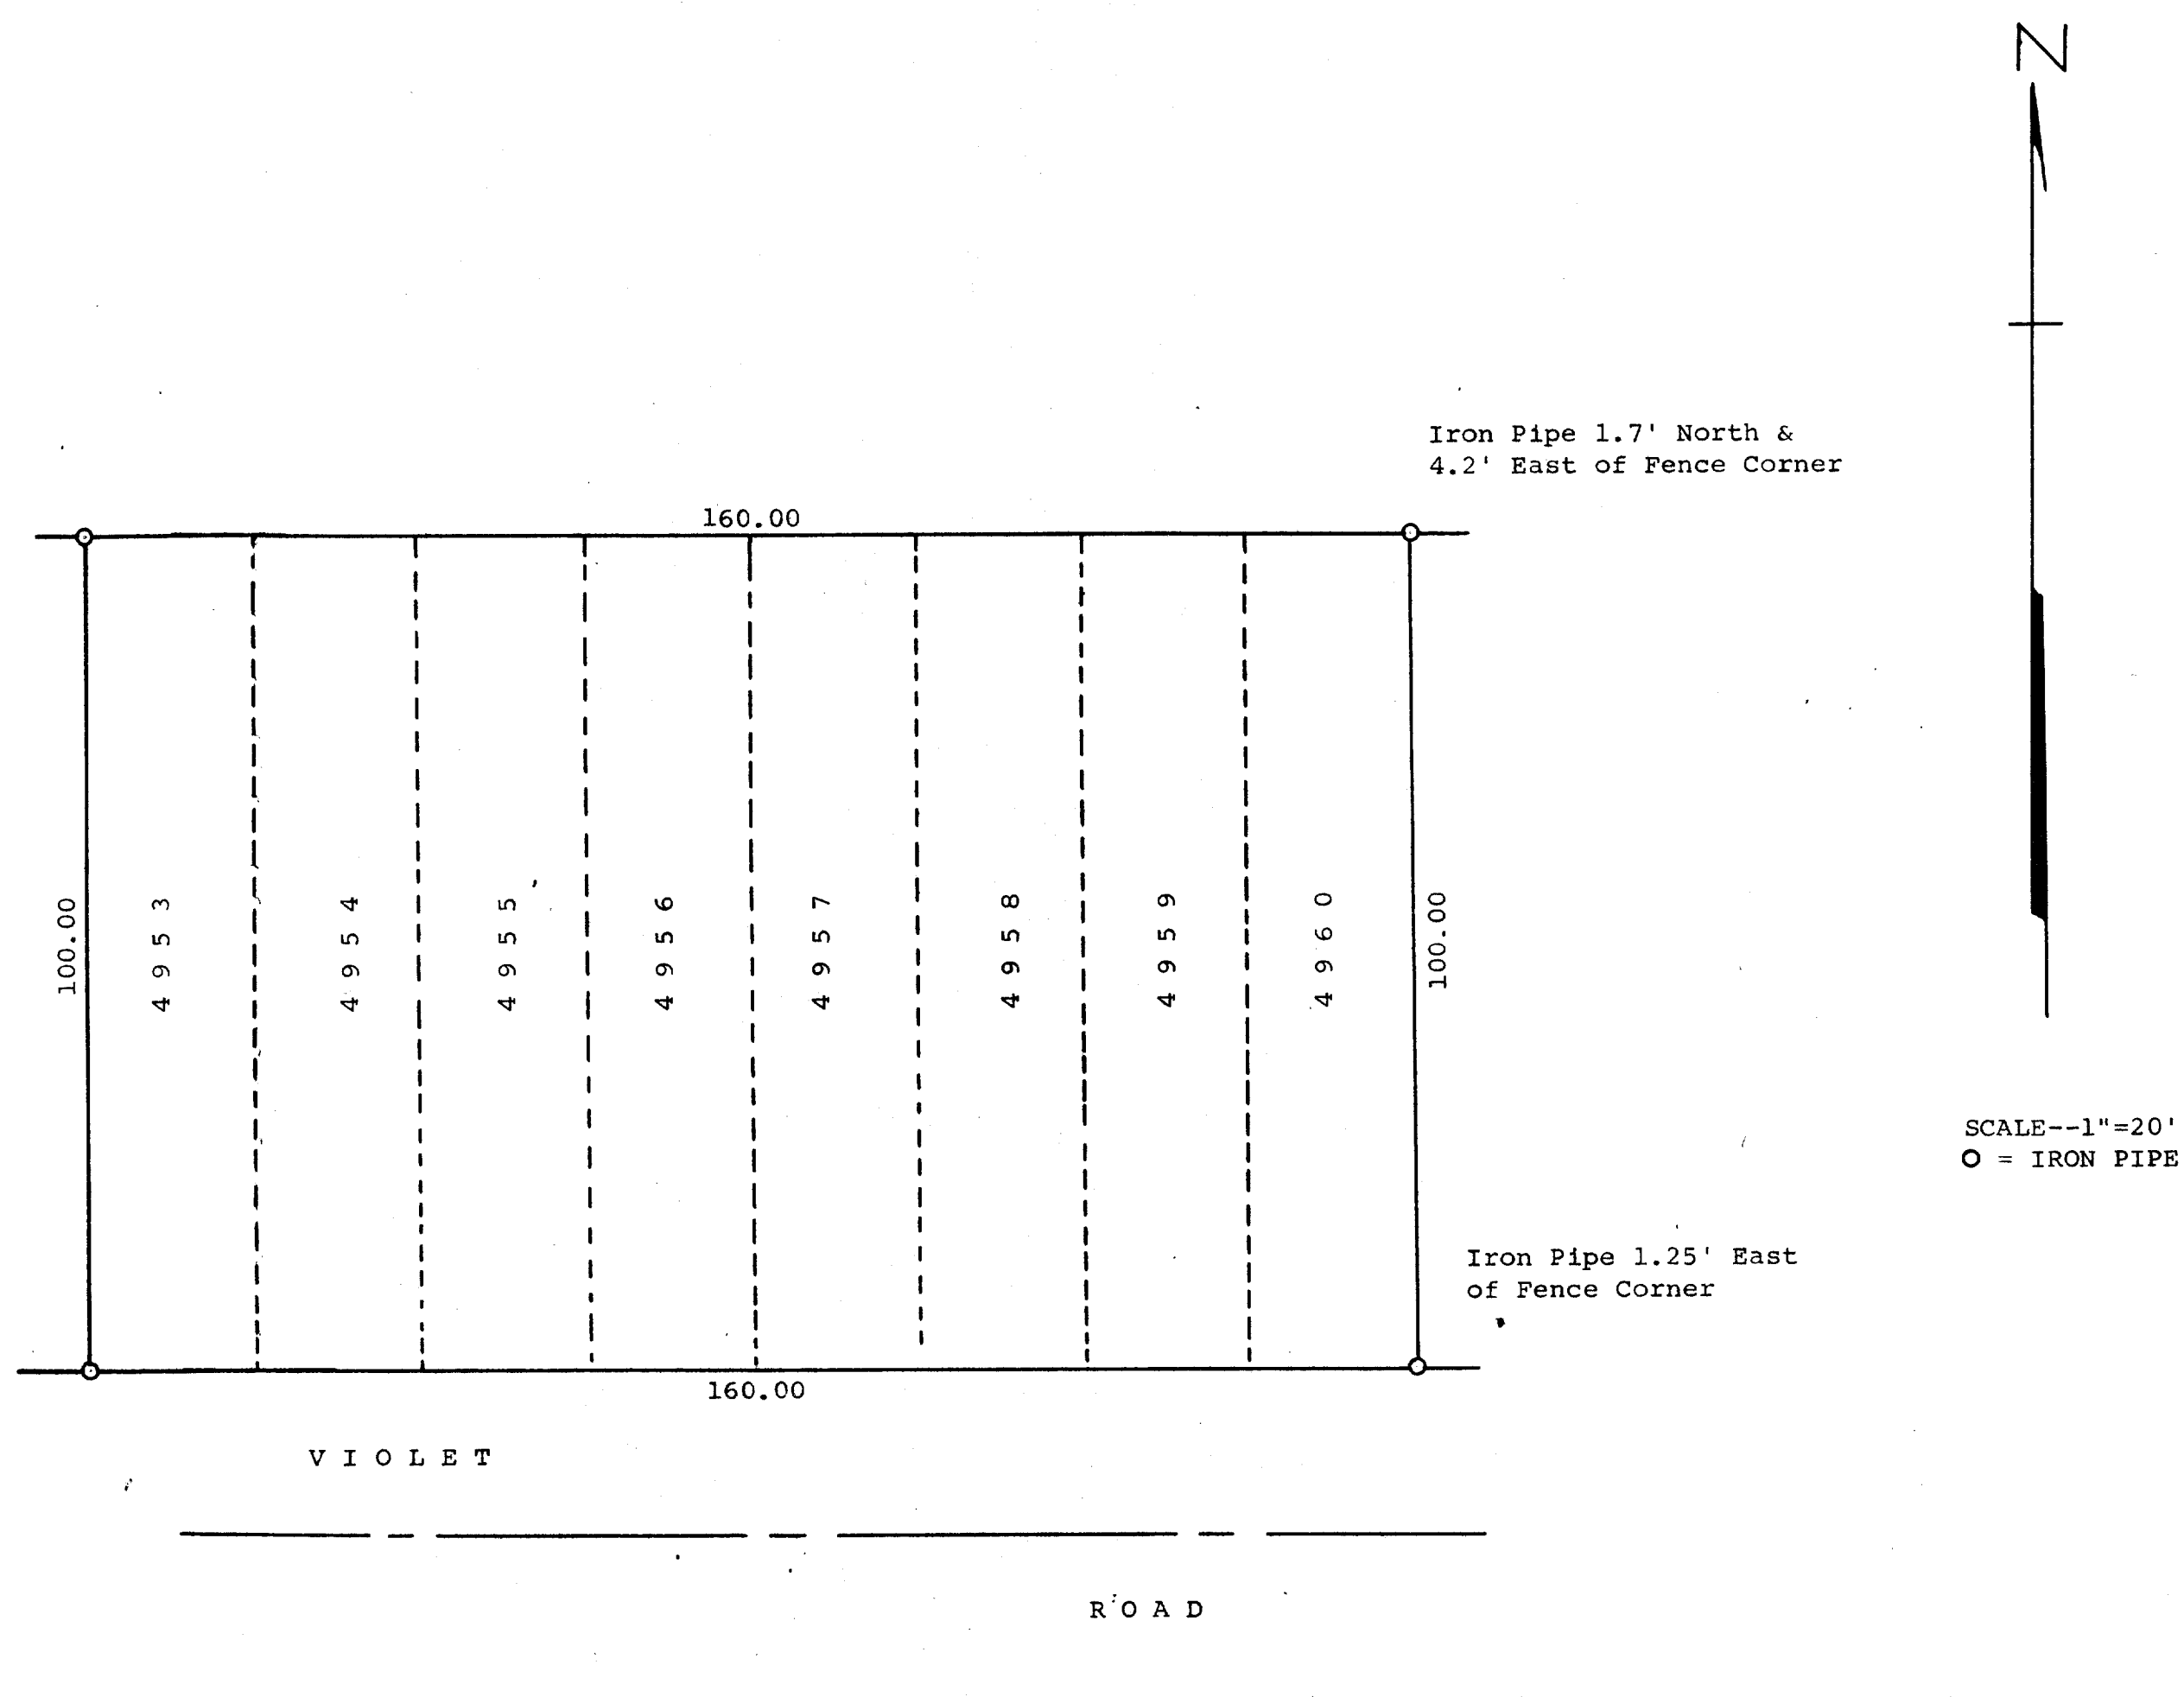

Plat of survey of Lots 4953-4960 Inclusive in Block 94, Section 3
of Pell Lake Subdivision, Town of Bloomfield, Walworth County, Wisconsin
October 3, 1961

George T. Dunham
George T. Dunham, Surveyor