


LOT 3, OF WILLIAM ELLIOT'S POWERS LAKE SUBDIVISION, LOCATED IN THE NORTHEAST
1/4 OF SECTION 13, T. 1 N., R. 18 E. TOWNSHIP OF BLOOMFIELD, WALWORTH COUNTY, WI.

♂ = IRON PIPE STAKE FOUND.

x = CROSS IN BRICK.

BEARINGS RELATE TO THE NORTH LINE OF LOT 3 WHICH WAS USED AS PLATTED AS S. 57°27' E.

✱✱✱ DENOTES FENCE LINE.

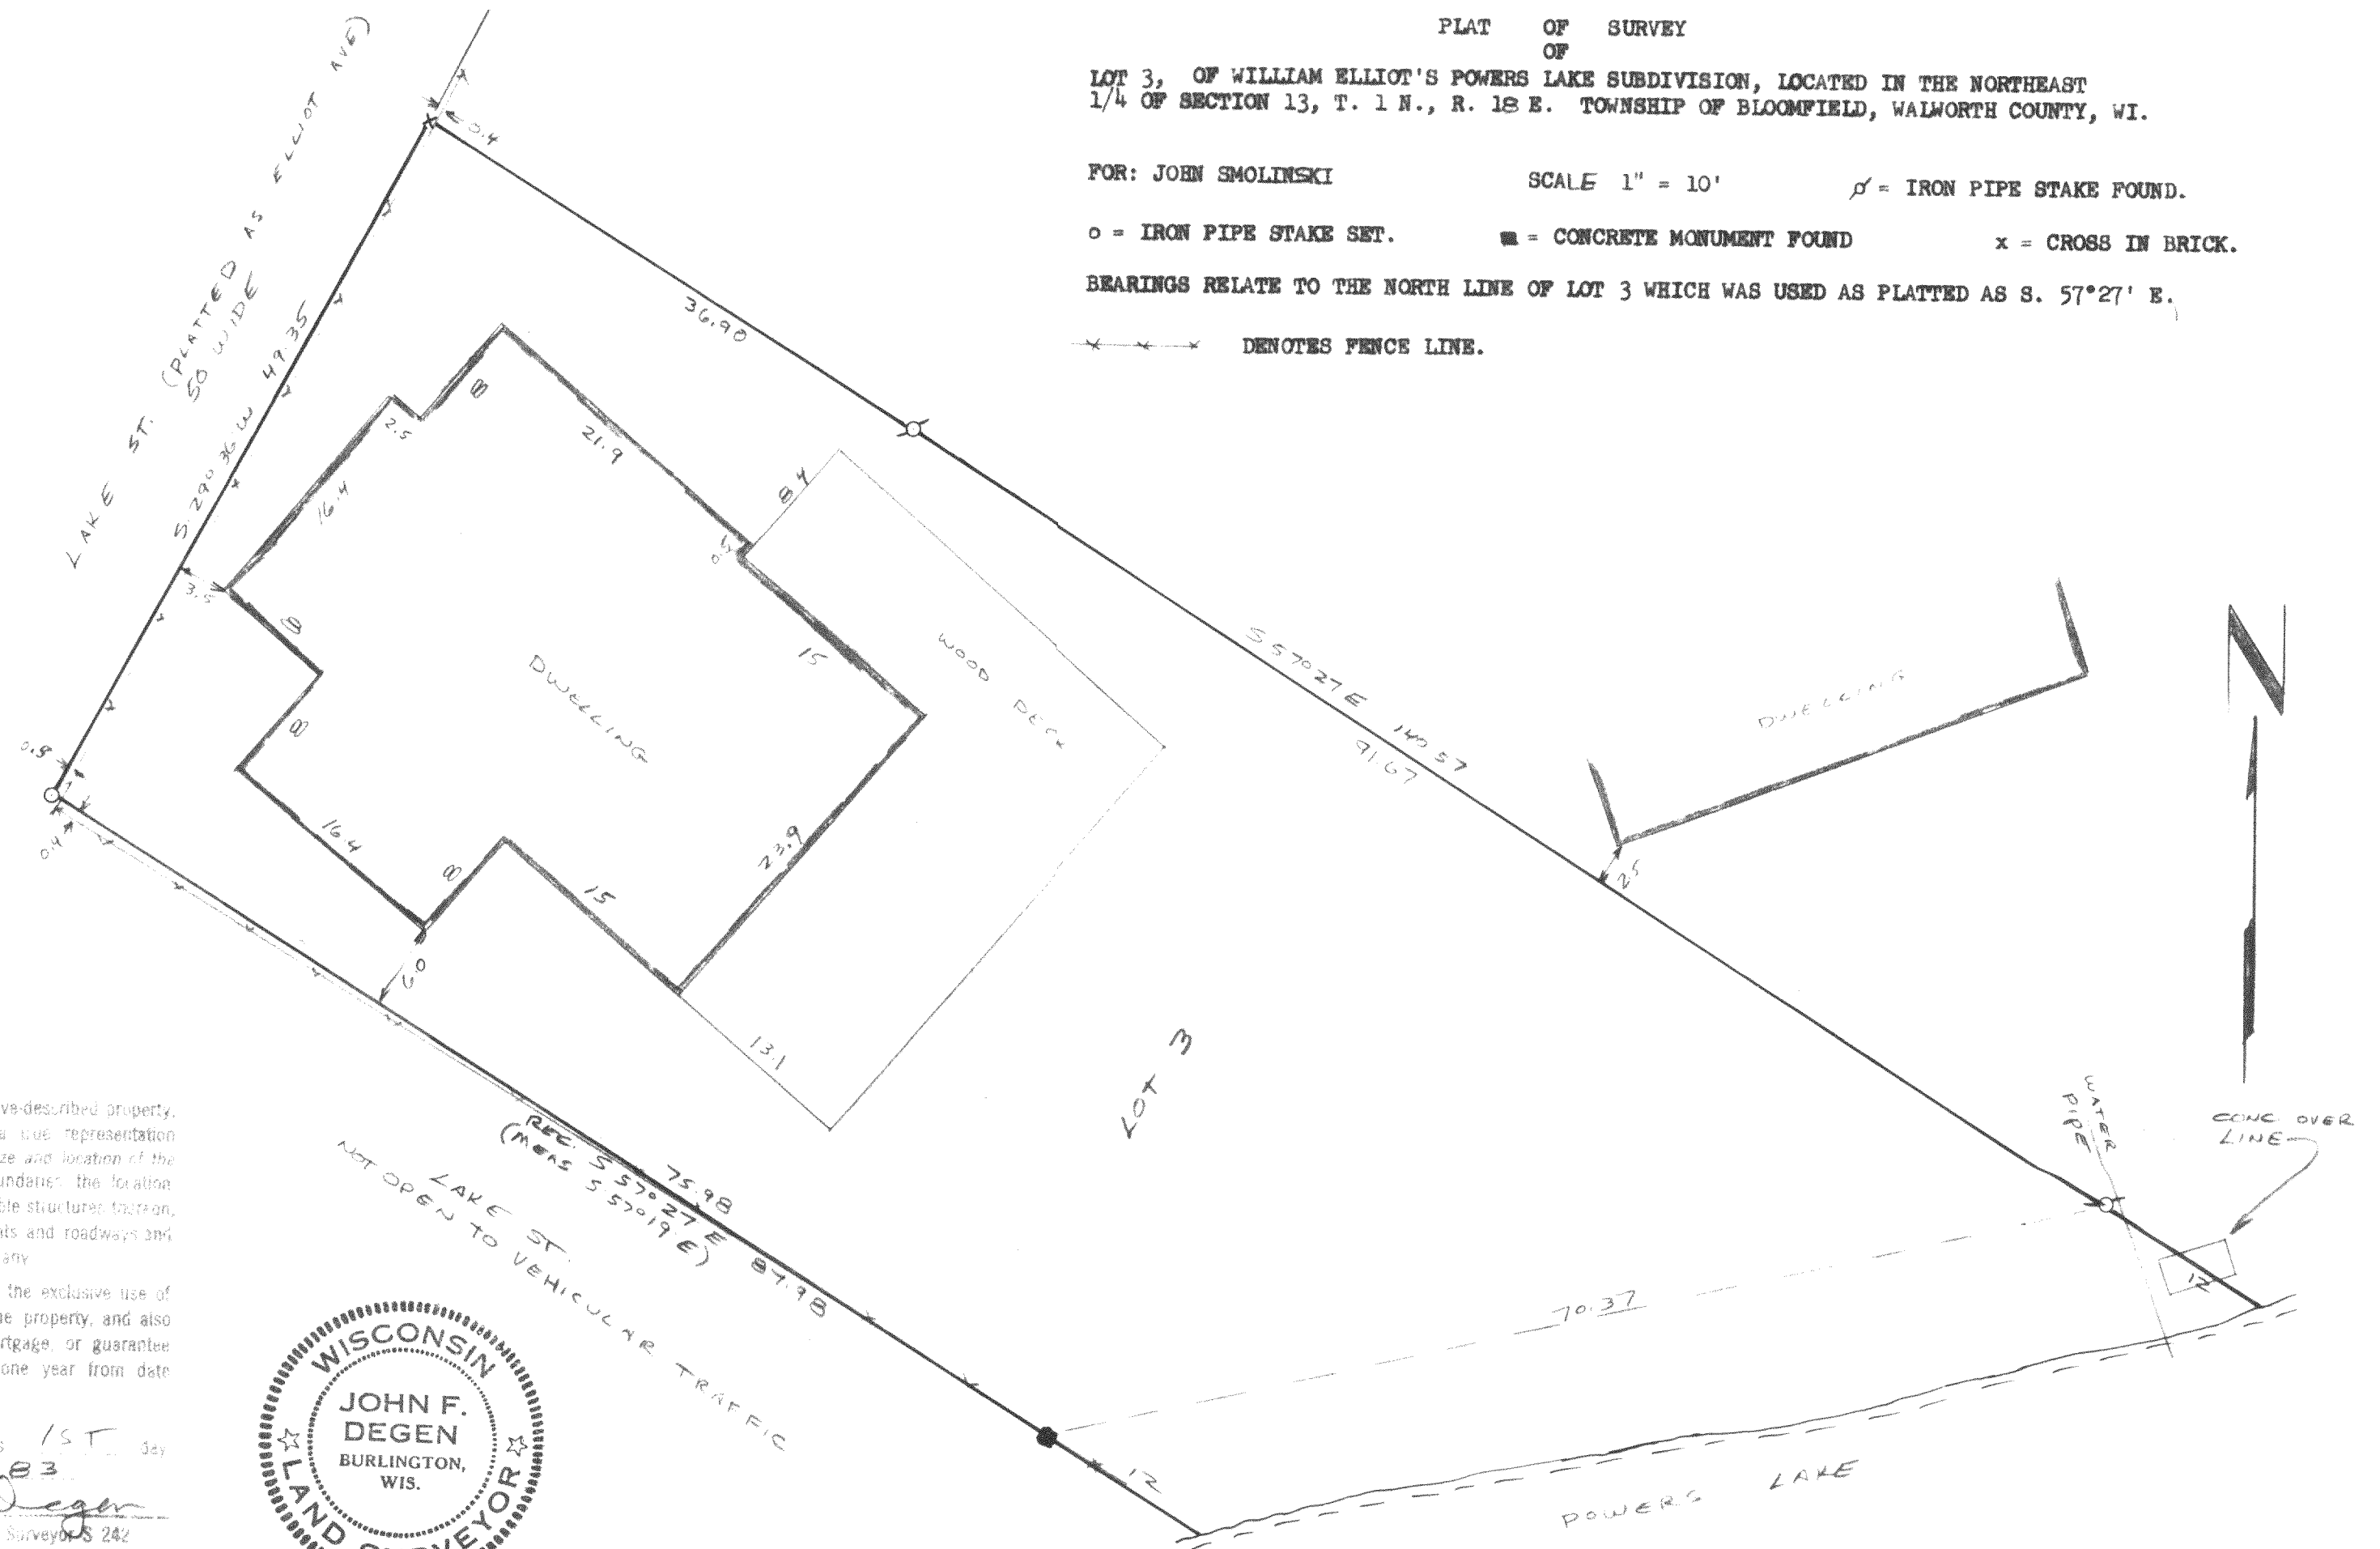

SEPT. 1983
John F. Degen
John F. Degen, Land Surveyor S 242

